

STATE ENGINEER  
Salem, Oregon

*Malh  
192*

# Well Record

*Malh 19.2*


STATE WELL NO. 15/47-30C(1)  
COUNTY Malheur  
APPLICATION NO. U-291

OWNER: Clair L. Gentry MAILING ADDRESS: Box 285

LOCATION OF WELL: Owner's No. \_\_\_\_\_ CITY AND STATE: Weiser, Idaho

NE 1/4 NW 1/4 Sec. 30 T. 15 S., R. 47 E., W.M.

Bearing and distance from section or subdivision corner S. 14° 42' W. of NW cor. Sec. 30, T. 15 S., R. 47 E.

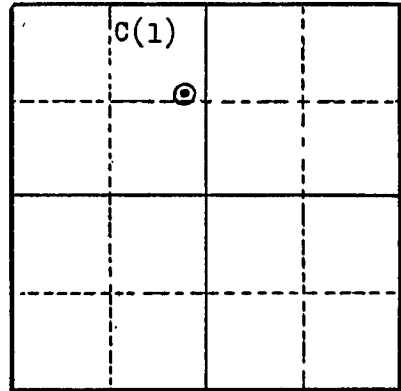

Section 30

Altitude at well \_\_\_\_\_

TYPE OF WELL: Dug Date Constructed 7-4-49

Depth drilled 19 Depth cased \_\_\_\_\_

CASING RECORD:

FINISH:

AQUIFERS:

8 feet

WATER LEVEL:

6.5 feet

PUMPING EQUIPMENT: Type \_\_\_\_\_ H.P. \_\_\_\_\_  
Capacity \_\_\_\_\_ G.P.M.

WELL TESTS:

Drawdown \_\_\_\_\_ ft. after \_\_\_\_\_ hours \_\_\_\_\_ G.P.M.  
Drawdown \_\_\_\_\_ ft. after \_\_\_\_\_ hours \_\_\_\_\_ G.P.M.

USE OF WATER Irrigation Temp. 60 °F., 19

SOURCE OF INFORMATION \_\_\_\_\_

DRILLER or DIGGER C. L. Gentry

ADDITIONAL DATA:

Log  Water Level Measurements \_\_\_\_\_ Chemical Analysis \_\_\_\_\_ Aquifer Test \_\_\_\_\_

REMARKS:

Diameter of well: 60" to 48"

