

STATE OF OREGON
WATER WELL REPORT
 (as required by ORS 537.765)

RECEIVED
MALH 1998
 MAY 13 1987

Malh
1998

19S/47E-32cb

(1) **OWNER:**
 Name City of Nyssa Well Number _____
 Address City Hall WATER RESOURCES DEPT.
 City NYSSA State OR Zip 97914
 SALEM, OREGON

(2) **TYPE OF WORK:**
 New Well Deepen Recondition Abandon

(3) **DRILL METHOD**
 Rotary Air Rotary Mud Cable
 Other _____

(4) **PROPOSED USE:**
 Domestic Community Industrial Irrigation
 Thermal Injection Other _____

(5) **BORE HOLE CONSTRUCTION:**
 Final Construction approval Yes No Depth of Completed Well 54 ft.
 Explosives used Yes No Type _____ Amount _____

HOLE		SEAL		Amount sacks or pounds
Diameter	From To	Material	From To	
18"	+1 19	Cement grout	+1 19	28 Sacks

How was seal placed: Method A B C D E
 Other _____
 Backfill placed from _____ ft. to _____ ft. Material _____
 Gravel placed from _____ ft. to _____ ft. Size of gravel _____

(6) **CASING/LINER:**

Diameter	From	To	Gauge	Steel	Plastic	Welded	Threaded
12"	+1'	44'	.250	<input checked="" type="checkbox"/>	<input type="checkbox"/>	<input checked="" type="checkbox"/>	<input type="checkbox"/>

Liner: _____
 Final location of shoe(s) 44'

(7) **PERFORATIONS/SCREENS:**
 Perforations Method Factory
 Screens Type _____ Material _____

From	To	Slot size	Number	Diameter	Tele/pipe size	Casing	Liner
24'	43'	1/8	400	12"		<input type="checkbox"/>	<input type="checkbox"/>

(8) **WELL TESTS: Minimum testing time is 1 hour**
 Pump Bailer Air Flowing Artesian
 Yield gal/min 200 Drawdown _____ Drill stem at _____ Time 2 1/2 hr.

Temperature of water 56° Depth Artesian Flow Found _____
 Was a water analysis done? No Yes By whom _____
 Did any strata contain water not suitable for intended use? Too little no
 Salty Muddy Odor Colored Other _____
 Depth of strata: _____

(9) **LOCATION OF WELL by legal description:**
 County Malheur Latitude 44-52 Longitude 117-00
 Township 19 S N or S Range 47 E E or W, WM.
 Section 32 NW 1/4 SW 1/4
 Tax Lot _____ Lot _____ Block _____ Subdivision _____
 Street Address of Well (or nearest address) Park Street

(10) **STATIC WATER LEVEL:**
9' ft. below land surface. Date Apr 22 87
 Artesian pressure _____ lb. per square inch. Date _____

(11) **WATER BEARING ZONES:**
 Depth at which water was first found 19'

From	To	Estimated Flow Rate	SWL
19'	39'		9'

(12) **WELL LOG:** Ground elevation _____

Material	From	To	SWL
Clay, brown	+1	19	
Sand & Gravel	19	39	9'
Clay, blue	39	54	

Two wells in city park
 This is the west well

Date started Apr 16-87 Completed Apr 22-87

(unbonded) **Water Well Constructor Certification:**
 I certify that the work I performed on the construction, alteration, or abandonment of this well is in compliance with Oregon well construction standards. Materials used and information reported above are true to my best knowledge and belief.
 Signed Frank Shelly WWC Number 789
 Date May 7-87

(bonded) **Water Well Constructor Certification:**
 I accept responsibility for the construction, alteration, or abandonment work performed on this well during the construction dates reported above. all work performed during this time is in compliance with Oregon well construction standards. This report is true to the best of my knowledge and belief.
 Signed Frank Shelly WWC Number 789
 Date May 7-87



Oregon Water Resources Department
725 Summer Street NE, Suite A
Salem Oregon 97301
(503) 986-0900
www.oregon.gov/owrd

Application for
Well ID Number

RECEIVED

SEP 21 2018

Do not complete if the well already has a Well Identification Number.

OWRD

I. OWNER INFORMATION

Current Owner Name (please print): City of Nyssa
Mailing Address: 301 Main Street
City, State, Zip: Nyssa, OR. 97913
Mail Well ID to: [X] SAME AS ABOVE [] In Care Of (C/O)
Name & Address:
City, State, Zip:

II. WELL LOCATION INFORMATION (Please fill out as completely as possible)

Township: 19S (North / South) Range: 47E (East / West) Section: 32 SE 1/4 of the NW 1/4
Tax Lot (usually last 3-5 numbers of Tax Map #): 7400 County Malheur
GPS Coordinates: 43deg 52' 27.38" N, 117deg 00' 03.00"W
Street Address of Well, City: WELL #8 on Ennis Street
If the property had a different street address in the past:


III. GENERAL WELL INFORMATION (Please fill out as completely as possible. AND attach copy of Well Report, if available)

Use of Well (domestic, irrigation, commercial, industrial, monitoring): Municipal
Date Well Constructed (or property built): 5/7/1987 Total Well Depth: 54 feet Casing Diameter: 12 inch
Owner at time the well was constructed (if known): City of Nyssa Well Report # (if known): MALH 1998
Other Information: West well in South City Park

SUBMITTED BY (please print): Michael E. Holladay for the City of Nyssa
PHONE: 208-741-1483 EMAIL &/or FAX: racememory@yahoo.com.

Send application to: Oregon Water Resources Department 725 Summer St NE, Suite A. Salem, Oregon 97301; or fax to (503) 986-0902.
Applications are processed in the order they are received, and Well ID Numbers are mailed within 4-5 business days.

For Official Use Only by the Oregon Water Resources Department:
Received Date: 9-21-18 Well Report Number: MALH 1998 Well Identification #: L-131848

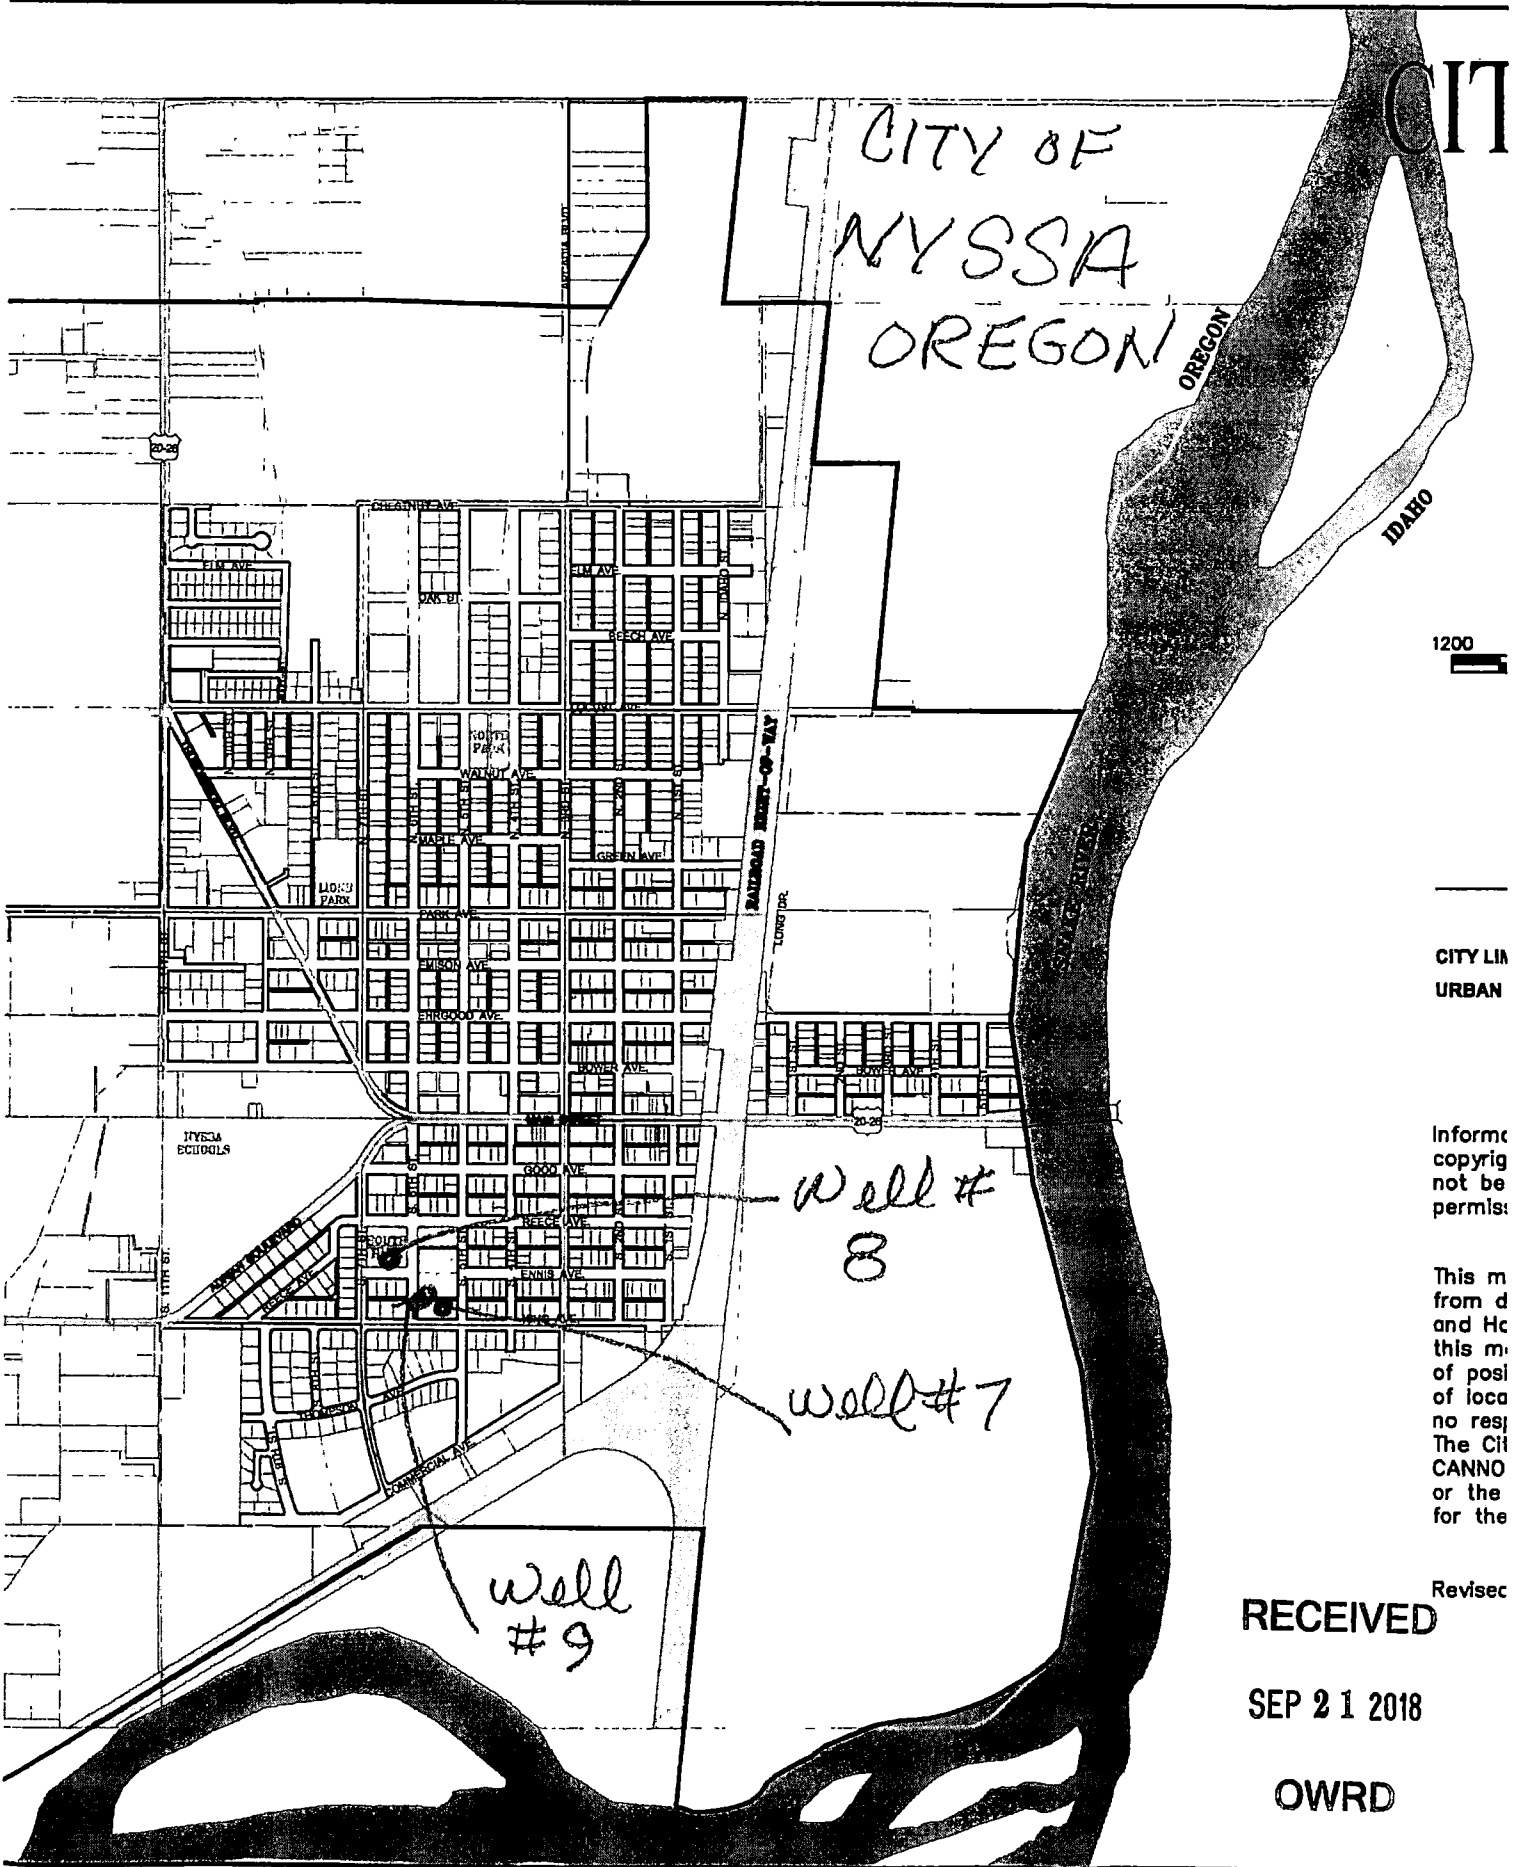

CITY OF
NYSSA
OREGON

CITY

OREGON

IDAHO

1200

CITY LINE
URBAN

Inform copyrig
not be permis:

This m
from d
and Hc
this m
of posi
of loca
no resp
The Cit
CANNO
or the
for the

Revisec

RECEIVED

SEP 21 2018

OWRD

Well #
8

well # 7

well
9