

STATE ENGINEER
Salem, Oregon

*Malh
207*

malh 207
Well Record


STATE WELL NO. 16/43-3N(1)
COUNTY Malheur
APPLICATION NO. G-1452

OWNER: Floyd McBride
MAILING ADDRESS:

LOCATION OF WELL: Owner's No. 1
CITY AND STATE: Jamison, Oregon

SW 1/4 SW 1/4 Sec. 3 T. 16 S., R. 43 W., W.M.

Bearing and distance from section or subdivision
corner N 31' 10" E. 262.3' from the SW
cor. Sec. 3, T. 16 S., R. 43 E.

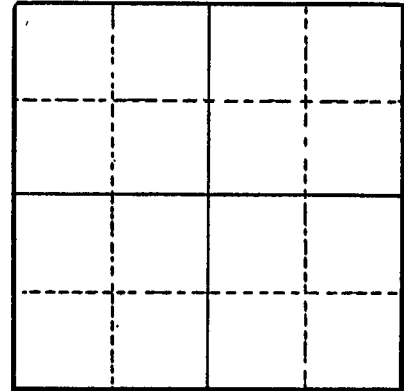

Section

Altitude at well

TYPE OF WELL: Dug Date Constructed 58-59

Depth drilled 29 Depth cased 19

CASING RECORD:

6-inch diameter

FINISH:

AQUIFERS:

WATER LEVEL:

5 feet

PUMPING EQUIPMENT: Type Centrifugal H.P. 25
Capacity 250 G.P.M.

WELL TESTS:

Drawdown ft. after hours G.P.M.

Drawdown ft. after hours G.P.M.

USE OF WATER Irrigation Temp. °F. 19

SOURCE OF INFORMATION G-1452

DRILLER or DIGGER

ADDITIONAL DATA:

Log Water Level Measurements Chemical Analysis Aquifer Test

REMARKS: