

STATE ENGINEER
Salem, Oregon

*Malh
209*

Well Record

Malh 209


STATE WELL NO. 16/43-4E1
COUNTY Malheur
APPLICATION NO. U-362

OWNER: North Jamieson Farms, Inc. MAILING ADDRESS: _____

LOCATION OF WELL: Owner's No. "South Well" CITY AND STATE: _____

SW 1/4 NW 1/4 Sec. 4 T. 16 N. S., R. 43 E., W.M.

Bearing and distance from section or subdivision corner 2640' S. & 40' E. from NW cor. Sec. 4

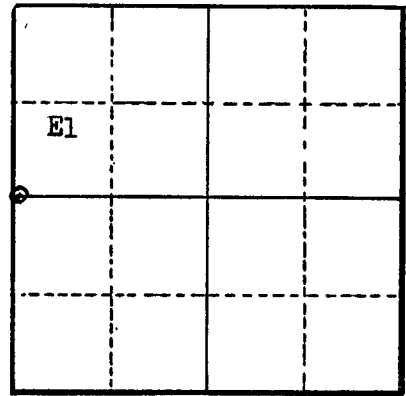

Section 4

Altitude at well _____

TYPE OF WELL: Drilled Date Constructed _____

Depth drilled _____ Depth cased _____

CASING RECORD:

FINISH:

AQUIFERS:

WATER LEVEL:

38 feet below land surface

PUMPING EQUIPMENT: Type Turbine H.P. 40
Capacity _____ G.P.M.

WELL TESTS:

Drawdown _____ ft. after _____ hours _____ G.P.M.

Drawdown _____ ft. after _____ hours _____ G.P.M.

USE OF WATER Irrigation Temp. _____ °F. _____, 19 _____

SOURCE OF INFORMATION _____

DRILLER or DIGGER _____

ADDITIONAL DATA:

Log _____ Water Level Measurements _____ Chemical Analysis _____ Aquifer Test _____

REMARKS:

