

STATE ENGINEER  
Salem, Oregon

*Malh  
211*

# Well Record

*malh 211*

STATE WELL NO. 16/43-4K(1)  
COUNTY Malheur  
APPLICATION NO. U-535

OWNER: Elbert E. Myers MAILING ADDRESS: \_\_\_\_\_

LOCATION OF WELL: Owner's No. Top well 2 CITY AND STATE: Jamison, Oregon


NW 1/4 SE 1/4 Sec. 4 T. 16 N. S., R. 43 E. W., W.M.

Bearing and distance from section or subdivision corner \_\_\_\_\_

Altitude at well \_\_\_\_\_

TYPE OF WELL: drilled Date Constructed \_\_\_\_\_

Depth drilled 710 Depth cased \_\_\_\_\_

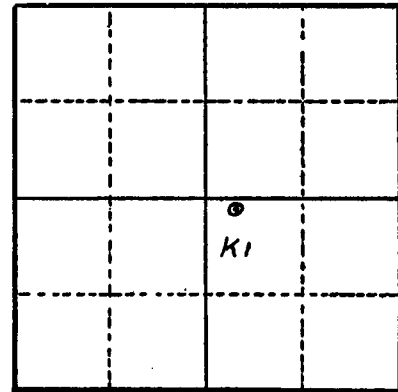

Section 4

CASING RECORD: 12 inch

FINISH: \_\_\_\_\_

AQUIFERS: 650 ft. to ?

WATER LEVEL: 50 ft. below LSD in 1951

PUMPING EQUIPMENT: Type turbine H.P. 15  
Capacity \_\_\_\_\_ G.P.M.

WELL TESTS:  
Drawdown \_\_\_\_\_ ft. after \_\_\_\_\_ hours \_\_\_\_\_ G.P.M.  
Drawdown \_\_\_\_\_ ft. after \_\_\_\_\_ hours \_\_\_\_\_ G.P.M.

USE OF WATER irrigation Temp. \_\_\_\_\_ °F. \_\_\_\_\_, 19\_\_\_\_

SOURCE OF INFORMATION U-535

DRILLER or DIGGER C. H. Stanbery; Ontario, Oregon

ADDITIONAL DATA:  
Log \_\_\_\_\_ Water Level Measurements \_\_\_\_\_ Chemical Analysis \_\_\_\_\_ Aquifer Test \_\_\_\_\_

REMARKS: \_\_\_\_\_