

STATE ENGINEER  
Salem, Oregon

*Malh  
212*

# Well Record

*malh*

*212*

STATE WELL NO. 16/43-40(1)  
COUNTY Malheur  
APPLICATION NO. U-536

OWNER: Elbert E. Myers


MAILING ADDRESS:

LOCATION OF WELL: Owner's No.

CITY AND STATE: Jamieson, Oregon

SW 1/4 SE 1/4 Sec. 4 T. 16 N. S., R. 43 E. W., W.M.

Bearing and distance from section or subdivision corner

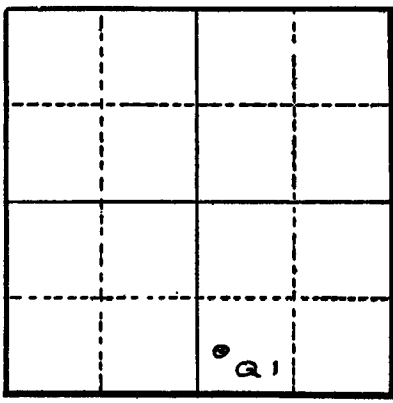

Section 4

Altitude at well

TYPE OF WELL: drilled Date Constructed 1951

Depth drilled 400 Depth cased

CASING RECORD: 12 inch

FINISH:

AQUIFERS:

WATER LEVEL: 12 ft. below LSD in 1951

PUMPING EQUIPMENT: Type turbine H.P. 25  
Capacity G.P.M.

WELL TESTS:  
Drawdown ft. after hours G.P.M.  
Drawdown ft. after hours G.P.M.

USE OF WATER irrigation Temp. °F., 19

SOURCE OF INFORMATION U-536

DRILLER or DIGGER C. H. Stanbery; Ontario, Oregon

ADDITIONAL DATA:  
Log Water Level Measurements Chemical Analysis Aquifer Test

REMARKS: