

STATE ENGINEER
Salem, Oregon

*Math
215*

Well Record

Math 215


STATE WELL NO. 16/43-4D2
COUNTY Malheur
APPLICATION NO. U-362

OWNER: North Jamieson Farms, Inc. MAILING ADDRESS: _____

LOCATION OF WELL: Owner's No. "Middle Well" CITY AND STATE: Jamieson, Oregon

NW 1/4 NW 1/4 Sec. 4 T. 16 N. R. 43 W., W.M.

Bearing and distance from section or subdivision
corner 1270' S. and 40' E. from NW cor.
Sec. 4

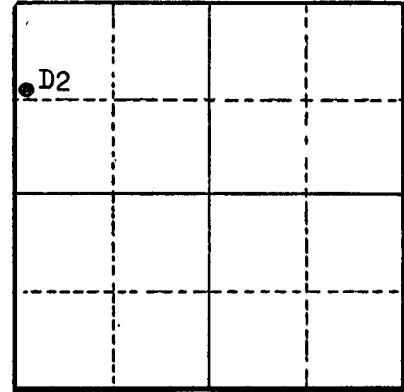

Section 4

Altitude at well _____

TYPE OF WELL: Drilled Date Constructed _____

Depth drilled _____ Depth cased _____

CASING RECORD:

FINISH:

AQUIFERS:

WATER LEVEL:

36 feet below land surface

PUMPING EQUIPMENT: Type Turbine H.P. 50
Capacity _____ G.P.M.

WELL TESTS:

Drawdown _____ ft. after _____ hours _____ G.P.M.

Drawdown _____ ft. after _____ hours _____ G.P.M.

USE OF WATER Irrigation Temp. _____ °F. _____, 19____

SOURCE OF INFORMATION _____

DRILLER or DIGGER _____

ADDITIONAL DATA:

Log _____ Water Level Measurements _____ Chemical Analysis _____ Aquifer Test _____

REMARKS:

STATE ENGINEER
Salem, Oregon

State Well No. 16/43-4 D(2)

County MALHEUR

Application No. U 362

Water Level Record

OWNER: NORTH JAMISON FARM, INC. OWNER'S NO. "Middle Well"

Description of measuring point: Air line

Date	Water Level Feet (above) Land Surface	Remarks	Date	Water Level Feet (above) Land Surface	Remarks
<u>10-14-50</u>	<u>36</u>	<u>Final Peak Survey</u>			

REMARKS: _____

