

STATE ENGINEER
Salem, Oregon

Malh 217

Well Record

malh 217


STATE WELL NO. 16/43-5B
COUNTY Malheur
APPLICATION NO. U-384

OWNER: F. W. Cammonn MAILING ADDRESS: _____

LOCATION OF WELL: Owner's No. _____ CITY AND STATE: Jamieson, Oregon

NW 1/4 NE 1/4 Sec. 5 T. 16 N. S., R. 43 E. W., W.M.

Bearing and distance from section or subdivision corner _____

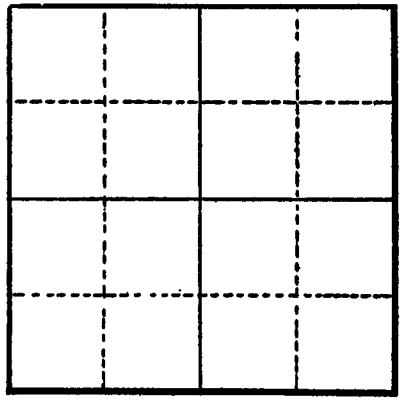

Altitude at well _____

TYPE OF WELL: drilled Date Constructed 1949

Depth drilled 230 Depth cased _____

Section _____

CASING RECORD: 12 inch

FINISH:

AQUIFERS:

WATER LEVEL:

PUMPING EQUIPMENT: Type turbine H.P. _____
Capacity _____ G.P.M.

WELL TESTS:
Drawdown _____ ft. after _____ hours _____ G.P.M.
Drawdown _____ ft. after _____ hours _____ G.P.M.

USE OF WATER irrigation Temp. _____ °F., 19 _____

SOURCE OF INFORMATION _____
DRILLER or DIGGER Duff Stevens

ADDITIONAL DATA:
Log _____ Water Level Measurements _____ Chemical Analysis _____ Aquifer Test _____

REMARKS: