

STATE ENGINEER  
Salem, Oregon

*Malh 218*

# Well Record

*malh 218*

STATE WELL NO. 16/43-5D(1)  
COUNTY Malheur  
APPLICATION NO. U-383

OWNER: F. W. Cammann

MAILING ADDRESS: .....

LOCATION OF WELL: Owner's No. 2

CITY AND STATE: Jamieson, Oregon


NW  $\frac{1}{4}$  NW  $\frac{1}{4}$  Sec. 5 T. 16 S., R. 43 <sup>N.</sup> ~~W.~~ <sup>E.</sup> W.M.

Bearing and distance from section or subdivision corner .....

Altitude at well .....

TYPE OF WELL: drilled Date Constructed 1950

Depth drilled 240 Depth cased .....

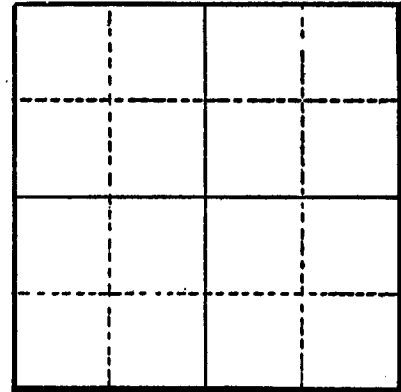

Section 5

CASING RECORD: 12 inch

FINISH:

AQUIFERS:

WATER LEVEL: 8 ft. below LSD

PUMPING EQUIPMENT: Type turbine H.P. 15  
Capacity ..... G.P.M.

WELL TESTS:  
Drawdown ..... ft. after ..... hours ..... G.P.M.  
Drawdown ..... ft. after ..... hours ..... G.P.M.

USE OF WATER irrigation Temp. .... °F. ...., 19.....

SOURCE OF INFORMATION .....

DRILLER or DIGGER H. Sevey

ADDITIONAL DATA:  
Log ..... Water Level Measurements ..... Chemical Analysis ..... Aquifer Test .....

REMARKS: