

STATE ENGINEER
Salem, Oregon

*Malheur
227*

Well Record

well #2 Malheur 227

STATE WELL NO. 16/43-7A(1)
COUNTY Malheur
APPLICATION NO. U-229


G5635 G5637

OWNER: Herbert M. Shaw Mailing Address: _____

LOCATION OF WELL: Owner's No. _____ CITY AND STATE: Jamieson, Oregon

NE 1/4 NE 1/4 Sec. 7 T. 16 N. S, R. 43 E. W., W.M.

Bearing and distance from section or subdivision corner _____

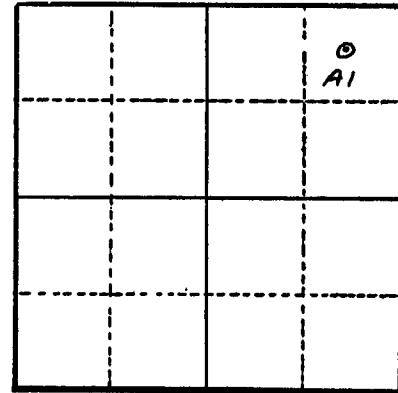

Section 7

Altitude at well _____

TYPE OF WELL: drilled Date Constructed 1946

Depth drilled 448 Depth cased _____

CASING RECORD: 12 inch

FINISH:

AQUIFERS:

WATER LEVEL: 14 ft. below land surface November 22, 1949

PUMPING EQUIPMENT: Type _____ H.P. _____
Capacity _____ G.P.M.

WELL TESTS:

Drawdown	76	ft. after	3	hours	pumping	450	G.P.M.
Drawdown	86	ft. after	3	hours	pumping	540	G.P.M.

USE OF WATER irrigation Temp. 60 °F. _____, 19_____

SOURCE OF INFORMATION U-229

DRILLER or DIGGER _____

ADDITIONAL DATA:

Log Water Level Measurements _____ Chemical Analysis _____ Aquifer Test _____

REMARKS:

