

STATE ENGINEER
Salem, Oregon

*Malh
232*

Well Record

malh 232

STATE WELL NO. 16/43-8F(1)
COUNTY Malheur
APPLICATION NO. U-228

OWNER: Herbert M. Shaw


MAILING
ADDRESS:

LOCATION OF WELL: Owner's No.

CITY AND
STATE: Jamieson, Oregon

SE $\frac{1}{4}$ NW $\frac{1}{4}$ Sec. 8 T. 16 N. S., R. 43 E. W., W.M.

Bearing and distance from section or subdivision
corner

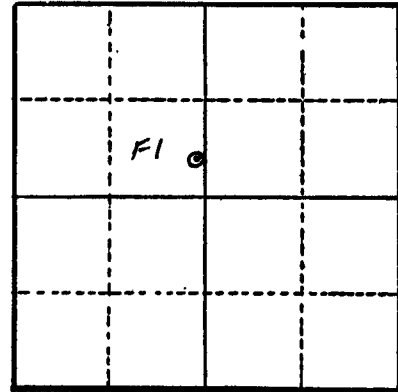

Section 8

Altitude at well

TYPE OF WELL: drilled Date Constructed 1946-49

Depth drilled 233 Depth cased

CASING RECORD: 8 inch

FINISH:

AQUIFERS:

WATER LEVEL: 8 ft. below land surface August 1949

PUMPING EQUIPMENT: Type turbine H.P. 15
Capacity G.P.M.

WELL TESTS:

Drawdown 52 ft. after 3 hours pumping 500 G.P.M.

Drawdown 62 ft. after 3 hours pumping 600 G.P.M.

USE OF WATER irrigation Temp. 65 °F. August 10, 1949

SOURCE OF INFORMATION

DRILLER or DIGGER C. Smoot

ADDITIONAL DATA:

Log Water Level Measurements Chemical Analysis Aquifer Test

REMARKS: