


MALH 2375
OBSERVATION WELL

STATE ENGINEER
Salem, Oregon

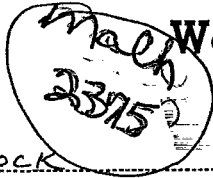

Well Record

STATE WELL NO. 29/37-17N(1)
COUNTY MALHEUR
APPLICATION NO. _____

OWNER: FRED PALLOCK MAILING ADDRESS: FOLLY FARM

LOCATION OF WELL: Owner's No. _____ CITY AND STATE: _____


SW $\frac{1}{4}$ SW $\frac{1}{4}$ Sec. 17 T. 29 ^{N.} S., R. 37 ^{E.} W., W.M.

Bearing and distance from section or subdivision corner _____

Altitude at well _____

TYPE OF WELL: DRILLED Date Constructed _____

Depth drilled 190' Depth cased _____

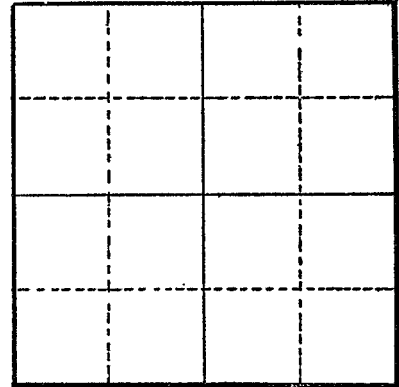

Section _____

CASING RECORD:

FINISH:

AQUIFERS:

WATER LEVEL:

93.52' (3-3-65)

PUMPING EQUIPMENT: Type _____ H.P. _____
Capacity _____ G.P.M.

WELL TESTS:

Drawdown _____ ft. after _____ hours _____ G.P.M.
Drawdown _____ ft. after _____ hours _____ G.P.M.

USE OF WATER STOCK Temp. _____ °F. _____, 19 _____

SOURCE OF INFORMATION FIELD Insp.

DRILLER or DIGGER _____

ADDITIONAL DATA:

Log NA Water Level Measurements ☒ Chemical Analysis _____ Aquifer Test _____

REMARKS: