

STATE ENGINEER
Salem, Oregon

Malh
321

Malh
321

Well Record

STATE WELL NO. 16/47-24F(1)
COUNTY Malheur
APPLICATION NO. G-121

OWNER: Tsutoma B. Imada


MAILING ADDRESS: Rt. 2, Box 315

LOCATION OF WELL: Owner's No. _____

CITY AND STATE: Ontario, Oregon

SE $\frac{1}{4}$ NW $\frac{1}{4}$ Sec. 24 T. 16 N. S., R. 47 E. W., W.M.

Bearing and distance from section or subdivision corner _____

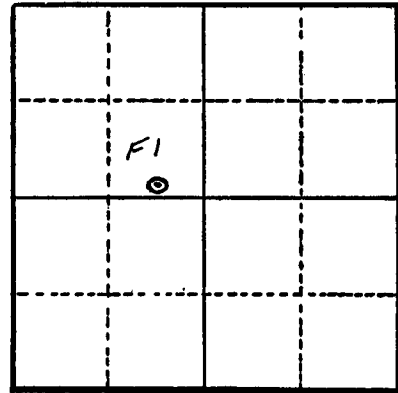

Section 24

Altitude at well _____

TYPE OF WELL: drilled Date Constructed Jan. 1955

Depth drilled 250 ft. Depth cased 63 ft.

CASING RECORD: 1 1/2 in. set to 63 ft.

FINISH: Perforations from 21 to 63 ft.

AQUIFERS:

WATER LEVEL: 20 ft. below land surface

PUMPING EQUIPMENT: Type _____ H.P. _____
Capacity _____ G.P.M.

WELL TESTS:
Drawdown 112 ft. after 4 hours pumping 550 G.P.M.
Drawdown _____ ft. after _____ hours _____ G.P.M.

USE OF WATER irrigation Temp. _____ °F. _____, 19____

SOURCE OF INFORMATION Well Drillers Report

DRILLER or DIGGER Skinner Bros.

ADDITIONAL DATA:
Log X Water Level Measurements _____ Chemical Analysis _____ Aquifer Test _____

REMARKS:

