

STATE ENGINEER  
Salem, Oregon

MALHEUR  
41

WELL RECORD


STATE WELL NO. 14/39-32H(1)  
COUNTY Malheur  
APPLICATION NO. U-840

OWNER: Ray Duncan MAILING ADDRESS: Box 554

LOCATION OF WELL: Owner's No. 2 CITY AND STATE: Ontario, Oregon

SE 1/4 NE 1/4 Sec. 32 T. 14 N. S. R. 39 W. W.M.

Bearing and distance from section or subdivision corner 23 chains S. and 11 chains W. from NE corner of Sec. 32, T. 14 S., R. 39 E.

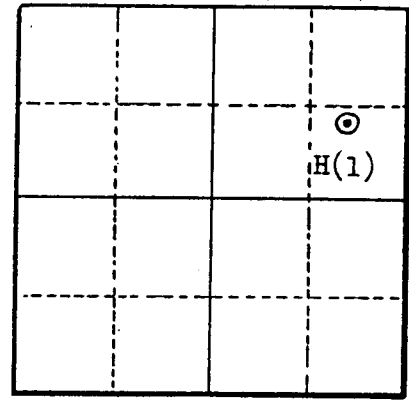

Section 32

Altitude at well

TYPE OF WELL: Date Constructed

Depth drilled 998 Depth cased

CASING RECORD:

12 inch

FINISH:

AQUIFERS:

WATER LEVEL:

165

PUMPING EQUIPMENT: Type H.P. 60 Capacity G.P.M.

WELL TESTS:

Drawdown 165 ft. after 6 hours 700 G.P.M.  
Drawdown ft. after hours G.P.M.

USE OF WATER Irrigation Temp. 76 °F. October 2, 1955

SOURCE OF INFORMATION U-840

DRILLER or DIGGER Holloway Drilling Co., Ontario Oregon

ADDITIONAL DATA:

Log Water Level Measurements Chemical Analysis Aquifer Test

REMARKS: