

STATE ENGINEER
Salem, Oregon

Well Record

STATE WELL NO. 17/44-36C(1)
COUNTY Malheur
APPLICATION NO. G-112


MALH
419

OWNER: J. P. Archuleta MAILING ADDRESS: _____

LOCATION OF WELL: Owner's No. _____ CITY AND STATE: Bridgeport, Oregon

NE ¼ NW ¼ Sec. 36 T. 17 S., R. 44 E. W.M.

Bearing and distance from section or subdivision corner 620' S. & 930' W. from N½ cor. Sec. 36

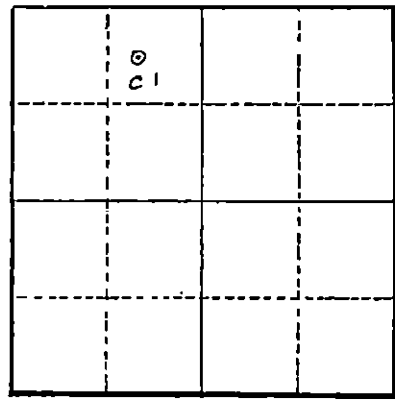

Section 36

Altitude at well _____

TYPE OF WELL: dug Date Constructed _____

Depth ~~drilled~~ 27 ft. Depth cased _____

CASING RECORD: Diameter 500 in.

FINISH: _____

AQUIFERS: _____

WATER LEVEL: _____

PUMPING EQUIPMENT: Type _____ H.P. _____
Capacity _____ G.P.M.

WELL TESTS:
Drawdown _____ ft. after _____ hours _____ G.P.M.
Drawdown _____ ft. after _____ hours _____ G.P.M.

USE OF WATER irrigation Temp. _____ °F. _____, 19 _____

SOURCE OF INFORMATION G-112

DRILLER or DIGGER _____

ADDITIONAL DATA:
Log _____ Water Level Measurements _____ Chemical Analysis _____ Aquifer Test _____

REMARKS: _____

