

MALH 525

STATE ENGINEER  
Salem, Oregon

*Malh*  
*525*  
*Malh*  
*525*

Well Record

STATE WELL NO. 17/47-10B(1)  
COUNTY Malheur  
APPLICATION NO. U-270

OWNER: Mrs. Glenn Scott

MAILING ADDRESS: \_\_\_\_\_

LOCATION OF WELL: Owner's No. \_\_\_\_\_

CITY AND STATE: Ontario, Oregon

NW 1/4 NE 1/4 Sec. 10 T. 17 <sup>N.</sup> S., R. 47 <sup>E.</sup> W., W.M.

Bearing and distance from section or subdivision corner well is S. 30° W. 1450 ft. from NW cor.


NE 1/4 NE 1/4 Sec. 10

Altitude at well \_\_\_\_\_

TYPE OF WELL: drilled Date Constructed 1948

Depth drilled 31 ft. Depth cased \_\_\_\_\_

CASING RECORD: 8 inch

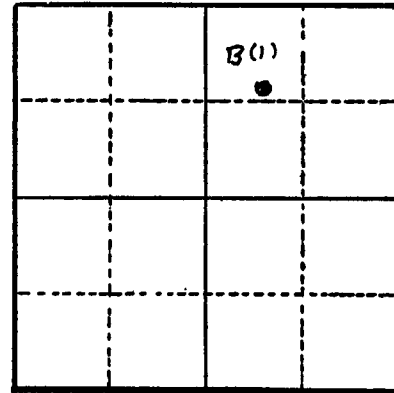

Section 10

FINISH: \_\_\_\_\_

AQUIFERS: \_\_\_\_\_

WATER LEVEL: 9 ft. below land surface

PUMPING EQUIPMENT: Type \_\_\_\_\_ H.P. \_\_\_\_\_  
Capacity \_\_\_\_\_ G.P.M.

WELL TESTS:  
Drawdown \_\_\_\_\_ ft. after \_\_\_\_\_ hours \_\_\_\_\_ G.P.M.  
Drawdown \_\_\_\_\_ ft. after \_\_\_\_\_ hours \_\_\_\_\_ G.P.M.

USE OF WATER irrigation 10.8 acres Temp. \_\_\_\_\_ °F. \_\_\_\_\_, 19\_\_\_\_\_

SOURCE OF INFORMATION \_\_\_\_\_

DRILLER or DIGGER \_\_\_\_\_

ADDITIONAL DATA:

Log  Water Level Measurements \_\_\_\_\_ Chemical Analysis \_\_\_\_\_ Aquifer Test \_\_\_\_\_

REMARKS: \_\_\_\_\_

