

STATE OF OREGON
 WATER SUPPLY WELL REPORT
 (as required by ORS 537.765 & OAR 690-205-0210)

WELL I.D. LABEL# L 114883
 START CARD # 1025677
 ORIGINAL LOG #

(1) LAND OWNER Owner Well I.D. _____
 First Name Dale Last Name Berrett
 Company Berrett Ranches
 Address 3540 Highway 95
 City Jordan Valley State OR Zip 97910

(2) TYPE OF WORK New Well Deepening Conversion
 Alteration (complete 2a & 10) Abandonment (complete 5a)

(2a) PRE-ALTERATION
 Dia + From To Gauge Stl Plstc Wld Thrd
 Casing:
 Seal: _____

(3) DRILL METHOD
 Rotary Air Rotary Mud Cable Auger Cable Mud
 Reverse Rotary Other _____

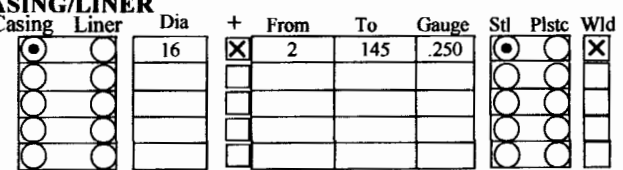
(4) PROPOSED USE Domestic Irrigation Community
 Industrial/ Commercial Livestock Dewatering
 Thermal Injection Other _____

(5) BORE HOLE CONSTRUCTION Special Standard (Attach copy)
 Depth of Completed Well 450 ft.

BORE HOLE			SEAL			Amt	sacks/ lbs
Dia	From	To	Material	From	To		
22	0	5	Bentonite Chips	0	145	141	S
20	5	145			Calculated	137	
15	145	450			Calculated		

How was seal placed: Method A B C D E
 Other Slow pour from top
 Backfill placed from _____ ft. to _____ ft. Material _____
 Filter pack from _____ ft. to _____ ft. Material _____ Size _____
 Explosives used: Yes Type _____ Amount _____

(5a) ABANDONMENT USING UNHYDRATED BENTONITE
 Proposed Amount Pounds Actual Amount Pounds

(6) CASING/LINER
 Casing Liner Dia + From To Gauge Stl Plstc Wld Thrd

 Shoe Inside Outside Other Location of shoe(s) _____
 Temp casing Yes Dia 20 From 1 To 5

(7) PERFORATIONS/SCREENS
 Perforations Method _____

RECEIVED BY OWRD

Perf/S green	Casing/ Liner	Screen Dia	From	To	Scr/slot width	Slot length	# of slots	Tel/ pipe size

DEC 04 2015
 SALEM, OR

(8) WELL TESTS: Minimum testing time is 1 hour
 Pump Bailer Air Flowing Artesian

Yield gal/min	Drawdown	Drill stem/Pump depth	Duration (hr)
550		450	1

Temperature 60 °F Lab analysis Yes By _____
 Water quality concerns? Yes (describe below) TDS amount 175
 From To Description Amount Units

From	To	Description	Amount	Units

(9) LOCATION OF WELL (legal description)
 County MALHEUR Twp 32 S N/S Range 40 E E/W WM
 Sec 15 NE 1/4 of the NE 1/4 Tax Lot 3201
 Tax Map Number _____ Lot _____
 Lat _____ " or 42.78133 DMS or DD
 Long _____ " or -117.7863 DMS or DD
 Street address of well Nearest address
 4344 - 4410 Idaho-Oregon-Nevada Hwy, Jordan Valley OR 97910

(10) STATIC WATER LEVEL
 Date SWL(psi) + SWL(ft)
 Existing Well / Pre-Alteration _____
 Completed Well 08-24-2015 _____ 95
 Flowing Artesian? Dry Hole?

WATER BEARING ZONES Depth water was first found 100

SWL Date	From	To	Est Flow	SWL(psi)	+ SWL(ft)
08-24-2015	100	105	100		95
08-24-2015	320	450	550		95

(11) WELL LOG Ground Elevation _____

Material	From	To
Topsoil	0	2
Soil Rocks & Clay	2	3
Lava Rock w/Brown & Tan Color	3	25
Black Lava Rock	25	75
Black Lava Rock	75	100
Fractured Lava Rock Black	100	105
Lava Rock Fractured	105	150
Red Lava w/Fractures	150	155
Hard Brown Fractured Clay	155	270
Hard Brown Fractured Clay	270	310
Hard Reddish Rock Frac.	310	320
Hard Clay Rock Frac.	320	330
Hard Rock w/Fractures	330	360
Hard Rock w/Fractures	360	390
Lava Rock w/Fractures	390	450

Date Started 03-02-2015 Completed 08-24-2015

(unbonded) Water Well Constructor Certification
 I certify that the work I performed on the construction, deepening, alteration, or abandonment of this well is in compliance with Oregon water supply well construction standards. Materials used and information reported above are true to the best of my knowledge and belief.

License Number _____ Date _____
 Signed _____

(bonded) Water Well Constructor Certification
 I accept responsibility for the construction, deepening, alteration, or abandonment work performed on this well during the construction dates reported above. All work performed during this time is in compliance with Oregon water supply well construction standards. This report is true to the best of my knowledge and belief.

License Number 1714 Date 11-30-2015
 Signed Dave Edmondson
 Contact Info (optional) _____