

STATE ENGINEER  
Salem, Oregon

# Well Record

STATE WELL NO. 15/40-2J1  
COUNTY Malheur  
APPLICATION NO. U-443

OWNER: Max Holloway

MAILING ADDRESS:


LOCATION OF WELL: Owner's No.

CITY AND STATE:

NE 1/4 SE 1/4 Sec. 2 T. 15 N. S., R. 40 E. W., W.M.

Bearing and distance from section or subdivision

corner 2702' S. and 73' W. of NE cor. Sec. 2

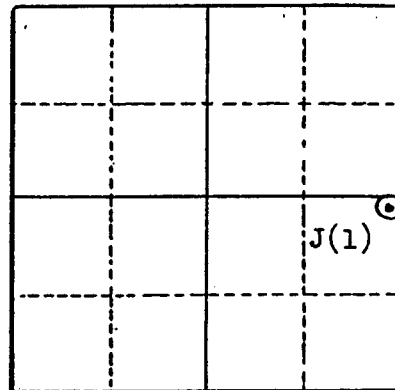

Section 2

Altitude at well 3897.77

TYPE OF WELL: Drilled Date Constructed 1949

Depth drilled 421 Depth cased 55

### CASING RECORD:

12 inch set to 55 feet

### FINISH:

Open hole below 55 feet

### AQUIFERS:

Sand and gravel from 97 to 100 feet  
Lava from 180 to 183 feet 320 to 326 feet and 421 to 427 feet

### WATER LEVEL:

19 feet, 1949

PUMPING EQUIPMENT: Type Turbine

H.P.

Capacity G.P.M.

### WELL TESTS:

Drawdown 31 ft. after 8 hours pumping 1,000 G.P.M.

Drawdown ft. after hours G.P.M.

USE OF WATER Irrigation Temp. 54 °F. July 21, 19

SOURCE OF INFORMATION U. S. G. S.

DRILLER or DIGGER Max Holloway

### ADDITIONAL DATA:

Log  Water Level Measurements  Chemical Analysis  Aquifer Test

### REMARKS:

Well is in NE 1/4 SE 1/4, Section 2. Listed as 2H1 in U.S.G.S. Report  
Discharge estimated on 7/21/55 at 500 gpm. (carpenter square method)

