

STATE ENGINEER
Salem, Oregon

Malheur 646
Well Record

STATE WELL NO. 17/47-32R(1)
COUNTY Malheur
APPLICATION NO. G-195

OWNER: Jack J. Koch

MAILING
ADDRESS:

LOCATION OF WELL: Owner's No.

CITY AND
STATE:

Ontario, Oregon

SE 1/4 SE 1/4 Sec. 32 T. 17 N. S. R. 47 E. W.M.


Bearing and distance from section or subdivision

corner

Altitude at well

TYPE OF WELL: dug Date Constructed 1946

Depth drilled 18 Depth cased

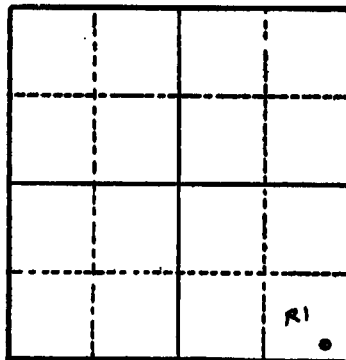

Section 32

CASING RECORD: Timber casing, well is 5' x 5' square

FINISH:

AQUIFERS:

WATER LEVEL: 4 1/2 to 5 ft. below land surface

PUMPING EQUIPMENT: Type Parma water lifter H.P. 3
Capacity 300 G.P.M.

WELL TESTS:

Drawdown ft. after hours G.P.M.

Drawdown ft. after hours G.P.M.

USE OF WATER irrigation Temp. °F., 19....

SOURCE OF INFORMATION G-195

DRILLER or DIGGER

ADDITIONAL DATA:

Log Water Level Measurements Chemical Analysis Aquifer Test

REMARKS:

State Well No. 11/47-32 R (1)

County Malheur

Application No. G-195

Water Level Record

OWNER: J. J. Koch OWNER'S NO.

Description of measuring point: Top of casing, 2.0' below LSD

[illegible]

REMARKS: