

STATE ENGINEER  
Salem, Oregon

# Well Record

STATE WELL NO. 15/40-2W(1) <sup>cba</sup>  
COUNTY Malheur  
APPLICATION NO. U-443

*MAX  
Holloway*

OWNER: Max Holloway

MAILING ADDRESS:


LOCATION OF WELL: Owner's No. #2

CITY AND STATE:

Ontario, Oregon

NW 1/4 SW 1/4 Sec. 2 T. 15 N. S., R. 40 E. W., W.M.

Bearing and distance from section or subdivision corner 2130' N. and 920' E. of the SW cor. of Sec. 2

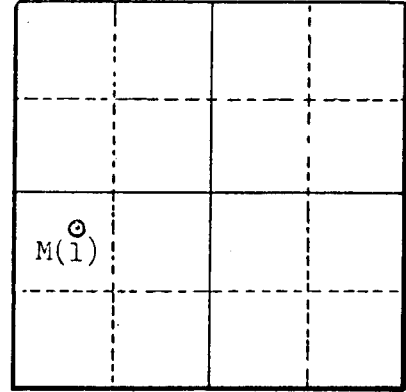

Section 2

Altitude at well 3916.28

TYPE OF WELL: Drilled Date Constructed 1952?

Depth drilled 535 Depth cased 250

### CASING RECORD:

12 inch, set to 250 feet

### FINISH:

Perforated from 40 to 100 feet  
Open hole below 250 feet

### AQUIFERS:

Sand and gravel from 83 to 100  
Lava rock from 393 to 535 feet

### WATER LEVEL:

40 feet below land surface 1952?

PUMPING EQUIPMENT: Type Turbine H.P.  
Capacity G.P.M.

### WELL TESTS:

Drawdown ft. after hours G.P.M.  
Drawdown ft. after hours G.P.M.

USE OF WATER Irrigation Temp. °F., 19.

SOURCE OF INFORMATION U.S.G.S.

DRILLER or DIGGER Max Holloway

### ADDITIONAL DATA:

Log  Water Level Measurements  Chemical Analysis  Aquifer Test

### REMARKS: