

STATE ENGINEER
Salem, Oregon

Well Record

STATE WELL NO. 15/40-2Q(1)
COUNTY Malheur
APPLICATION NO. U-305

MALH
68

OWNER: Rankin Crow

MAILING ADDRESS:


LOCATION OF WELL: Owner's No. #1

CITY AND STATE:

Brogan, Oregon

SW 1/4 SE 1/4 Sec. 2 T. 15 N. S., R. 40 W., W.M.

Bearing and distance from section or subdivision corner

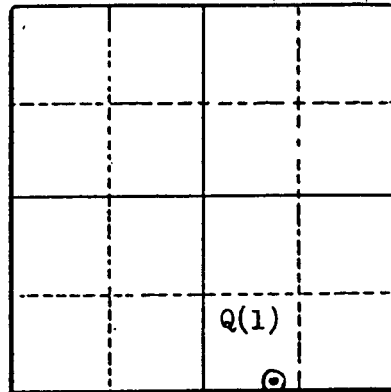

Altitude at well 3897.93

TYPE OF WELL: Drilled Date Constructed 1949

Depth drilled 362 Depth cased 121

Section 2

CASING RECORD:

10 inch set to 121 feet

FINISH:

Perforated from top to 121 feet

AQUIFERS:

Gravel from 114 to 118 feet Sand, cindery, from 305 to 308 feet

* WATER LEVEL:

25.49 feet below top of casing which is at land surface 1-12-56
17 feet below land surface May, 1949

PUMPING EQUIPMENT: Type Turbine H.P.
Capacity G.P.M.

WELL TESTS:

Drawdown 18 ft. after short period hours pumping 1,000 G.P.M.
Drawdown ft. after hours G.P.M.

USE OF WATER Irrigation Temp. 54 °F. 5-23, 19.55

SOURCE OF INFORMATION U.S.G.S.

DRILLER or DIGGER Max Holloway

ADDITIONAL DATA:

Log Water Level Measurements Chemical Analysis Aquifer Test

REMARKS:

55 feet of column. Sucked air in summer, 1955

*Water level 25.49 feet below land surface 1-12-56

Well to be equipped with 40 HP turbine in Spring, 1956 - 3 stage 50' of column

