

558

STATE ENGINEER
Salem, Oregon

Well Record

STATE WELL NO. 15/40-10B(1)
COUNTY Malheur
APPLICATION NO.

MALH
71

OWNER: Rankin Crow


MAILING ADDRESS:

LOCATION OF WELL: Owner's No. #3

CITY AND STATE: Brogan, Oregon

NW 1/4 NE 1/4 Sec. 10 T. 15 N. S. R. 40 W., W.M.

Bearing and distance from section or subdivision corner

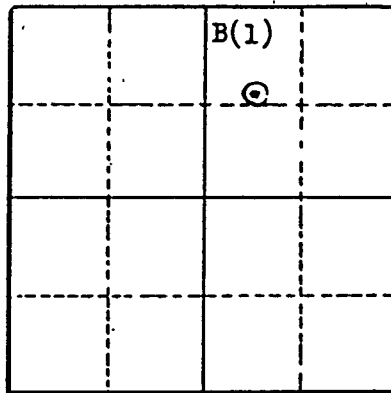

Altitude at well 3922.90

TYPE OF WELL: Drilled Date Constructed 1950

Depth drilled 255 Depth cased

Section 10

CASING RECORD:

12 inch, set to 130 feet

FINISH:

Perforated from 6 to 130 feet

AQUIFERS:

Sand and gravel from 50 to 54, and 94 to 104 feet. Gravel from 204 to 206 and 250 to 255 feet

WATER LEVEL:

42 feet, July, 1950

PUMPING EQUIPMENT: Type Turbine

H.P.

Capacity G.P.M.

WELL TESTS:

Drawdown 38 ft. after short period hours pumping 840 G.P.M.

Drawdown ft. after hours G.P.M.

USE OF WATER Irrigation Temp. °F., 19

SOURCE OF INFORMATION U.S.G.S.

DRILLER or DIGGER Max Holloway

ADDITIONAL DATA:

Log Water Level Measurements Chemical Analysis Aquifer Test

REMARKS:

