

520

STATE ENGINEER
Salem, Oregon

MALH
73

Well Record

STATE WELL NO. 15/40-11P(1)
COUNTY Malheur
APPLICATION NO.

OWNER: Rankin Crow

MAILING ADDRESS:


LOCATION OF WELL: Owner's No. #

CITY AND STATE:

Brogan, Oregon

SE 1/4 SW 1/4 Sec. 11 T. 40 N. S. R. 15 E. W.M.

Bearing and distance from section or subdivision corner

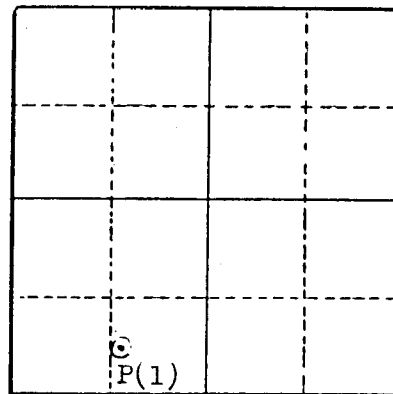

Section 11

Altitude at well 3920 by barometric traverse

TYPE OF WELL: Drilled Date Constructed 1950

Depth drilled 200 Depth cased

CASING RECORD:

12 inch set to 128 feet

FINISH:

AQUIFERS:

WATER LEVEL:

49.08 feet below land surface, September 12, 1954

PUMPING EQUIPMENT: Type Turbine H.P.
Capacity G.P.M.

WELL TESTS:

Drawdown	ft. after	hours	G.P.M.
Drawdown	ft. after	hours	G.P.M.

USE OF WATER Irrigation 163 acres Temp. 57 °F. May 26, 1955

SOURCE OF INFORMATION U.S.G.S.

DRILLER or DIGGER Max Holloway

ADDITIONAL DATA:

Log Water Level Measurements Chemical Analysis Aquifer Test

REMARKS: