

#565

STATE ENGINEER
Salem, Oregon

MALH
79

Well Record


STATE WELL NO. 15/40-14Q(1)
COUNTY Malheur
APPLICATION NO. U-434

OWNER: Rankin Crow MAILING ADDRESS:

LOCATION OF WELL: Owner's No. 8 CITY AND STATE: Brogan, Oregon

SW 1/4 SE 1/4 Sec. 14 T. 15 N. S., R. 40 E., W.M.

Bearing and distance from section or subdivision corner

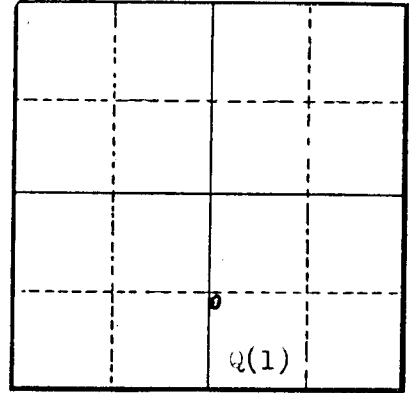

Altitude at well 3946 by barometric traverse

TYPE OF WELL: Drilled Date Constructed 1951

Depth drilled 248 Depth cased 157 1/2

Section 14

CASING RECORD:

14-inch, set to 157 1/2 feet

FINISH:

AQUIFERS:

WATER LEVEL:

96.98 feet below land surface, September 12, 1954

PUMPING EQUIPMENT: Type Turbine H.P. Capacity G.P.M.

WELL TESTS:

| | | | |
|----------|-----------|-------|--------|
| Drawdown | ft. after | hours | G.P.M. |
| Drawdown | ft. after | hours | G.P.M. |

USE OF WATER Irrigation Temp. 59 1/2 °F May 26, 1955

SOURCE OF INFORMATION U. S. G. S., Obs.

DRILLER or DIGGER Max Holloway

ADDITIONAL DATA:

Log Water Level Measurements Chemical Analysis Aquifer Test

REMARKS: