

#1006

STATE ENGINEER
Salem, Oregon

MALH 87

Well Record

STATE WELL NO. 15/41-7J
COUNTY Malheur
APPLICATION NO. U-421

OWNER: Rankin Crow

MAILING ADDRESS:


LOCATION OF WELL: Owner's No.

CITY AND STATE:

Brogan, Oregon

NE 1/4 SE 1/4 Sec. 7 T. 15 S., R. 41 W., W.M.

Bearing and distance from section or subdivision corner

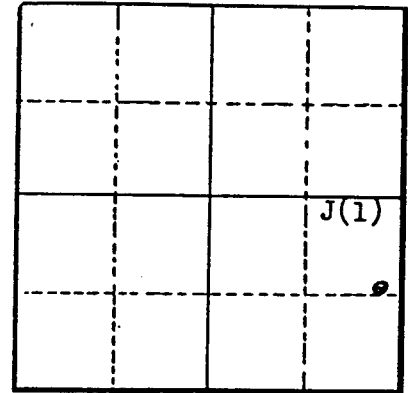

Section

Altitude at well 3917 by barometric traverse

TYPE OF WELL: Drilled Date Constructed 1951

Depth drilled 360 Depth cased 100

CASING RECORD:

12 inch set to 100 feet

FINISH:

open hole

AQUIFERS:

gravel from 320 to 360 feet

WATER LEVEL:

PUMPING EQUIPMENT: Type Turbine H.P.
Capacity G.P.M.

WELL TESTS:

Drawdown ft. after hours G.P.

Drawdown ft. after hours G.P.

USE OF WATER Irrigation Temp. 65 °F. May 25, 1951

SOURCE OF INFORMATION U.S.G.S., Rankin Crow

DRILLER or DIGGER

ADDITIONAL DATA:

Log Water Level Measurements Chemical Analysis Aquifer Test

REMARKS:

Log given in U. S. G. S. report for well 7H(1) is log of 8M(1)
(This well is slightly higher in elevation than well 8M(1), as the irrigation ditch fed by well flowed on the uphill side of well 8M(1).