

STATE ENGINEER
Salem, Oregon

*Malh
009*

Well Record

malh 009


STATE WELL NO. 14/38-27F(1)
COUNTY Malheur
APPLICATION NO. U-762

OWNER: Raleigh Van Buren MAILING ADDRESS:

LOCATION OF WELL: Owner's No. 2 CITY AND STATE: Ironside, Oregon

SE 1/4 NW 1/4 Sec. 27 T. 14 S., R. 38 E., W.M.

Bearing and distance from section or subdivision corner S. 43° E. 2365' from NW cor. of Section 27, T. 14 S., R. 38 E.

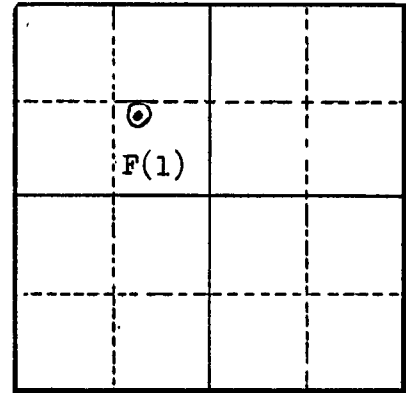

Section 27

Altitude at well

TYPE OF WELL: Date Constructed 3-23-54

Depth drilled 170 Depth cased 32

CASING RECORD:

32 feet of 12" casing

FINISH:

AQUIFERS:

15'

WATER LEVEL:

22'

PUMPING EQUIPMENT: Type H.P. 15
Capacity 500 G.P.M.

WELL TESTS:
Drawdown 69 ft. after 5 3/4 hours 500 G.P.M.
Drawdown ft. after hours G.P.M.

USE OF WATER Irrigation Temp. 55 °F. March 22, 1953

SOURCE OF INFORMATION U-762

DRILLER or DIGGER Holloway Drilling Co. Ontario, Oregon

ADDITIONAL DATA:

Log Water Level Measurements Chemical Analysis Aquifer Test

REMARKS:

