

#604

MALH 90

STATE ENGINEER  
Salem, Oregon

# Well Record

STATE WELL NO. 15/41-8N(1)  
COUNTY Malheur  
APPLICATION NO. U-421

OWNER: Rankin Crow

MAILING ADDRESS:

LOCATION OF WELL: Owner's No.


CITY AND STATE:

Brogan, Oregon

SW 1/4 SW 1/4 Sec. 8 T. 15 N. S., R. 41 E. W., W.M.

Bearing and distance from section or subdivision

corner 730' E. & 55' S. of NW cor. of SW 1/4 Sec. 8

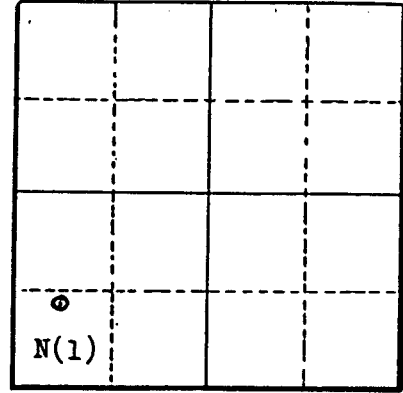

Section 8

Altitude at well 3920 by barometric traverse

TYPE OF WELL: Drilled Date Constructed 1951

Depth drilled 338 Depth cased 150

### CASING RECORD:

12-inch, set to 150

### FINISH:

### AQUIFERS:

### WATER LEVEL:

52.20 feet below land surface, August 4, 1953

PUMPING EQUIPMENT: Type Turbine H.P.  
Capacity G.P.M.

### WELL TESTS:

Drawdown ft. after hours G.P.M.  
Drawdown ft. after hours G.P.M.

USE OF WATER Irrigation Temp. 67 °F. May 25, 1955  
SOURCE OF INFORMATION U.S.G.S., Rankin Crow, obs.

DRILLER or DIGGER

### ADDITIONAL DATA:

Log  Water Level Measurements  Chemical Analysis  Aquifer Test

REMARKS: Log given in U.S.G.S. report for Well #6 is the log for Well #7  
(Holloway's well Nos. for Crow wells #6 & #7 are as follows:  
Crow No. 6 = Holloway No. 7, and Crow No. 7 = Holloway #6



Changed to ~~11~~ → #6

RECEIVED

AUG 27 1951

STATE ENGINEER  
SALEM, OREGON

Log of CROW Well No. 7  
application No. U-422

Top soil	0 to 75 feet
Gravel and water	75 to 80 "
Clay	80 to 95 "
Sand and gravel water	95 to 140 "
Hard clay	140 to 314 "
Hard rock	314 to 344 "
Loose rock and water	334 to 338 "

150 feet 12<sup>3</sup>/<sub>4</sub>" casing installed

Water level 46 feet

Well tested by Parma Water Lifter Co.

By Max Holloway

Reported by B. Crow to be in his number designation  
No. 6 & the log listed as No. 6 is his No. 7