

STATE ENGINEER
Salem, Oregon

7085
M 131.222

Well Record

STATE WELL NO. 4/W - 3481
COUNTY MARION
APPLICATION NO. GR-1927

OWNER: John H. Strawn


MAILING ADDRESS: Route 1

LOCATION OF WELL: Owner's No.

CITY AND STATE: Hubbard, Oregon

SE 1/4 SE 1/4 Sec. 34 T. 4 N. S., R. 1 W., W.M.

Bearing and distance from section or subdivision corner S. 1566' & W. 496'

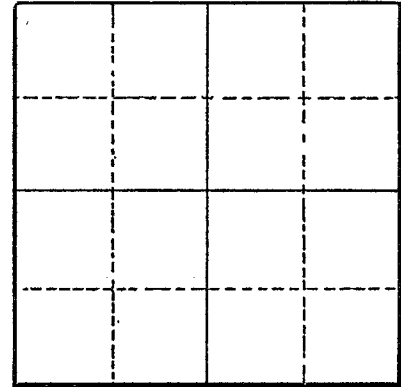

Section

Altitude at well 172'

TYPE OF WELL: Drilled Date Constructed 1951

Depth drilled 109 Depth cased 109

CASING RECORD:

8-inch

FINISH:

Perforation from 94 to 109

AQUIFERS:

WATER LEVEL:

21-feet

PUMPING EQUIPMENT: Type Cook Turbine H.P. 5
Capacity 120 G.P.M.

WELL TESTS:

Drawdown 48 ft. after hours Pumping 150 G.P.M.
Drawdown 65 ft. after hours Pumping 295 G.P.M.

USE OF WATER Irrigation - 9 1/2 acres Temp. °F. 19

SOURCE OF INFORMATION GR-1927

DRILLER or DIGGER Coleman

ADDITIONAL DATA:

Log Water Level Measurements Chemical Analysis Aquifer Test

REMARKS: