

STATE ENGINEER
Salem, Oregon

MAR 10/16

Well Record


STATE WELL NO. 4/1W-35D(1)
COUNTY Marion
APPLICATION NO. GR-751

OWNER: Boyd E. Brown
MAILING ADDRESS: Route 1

LOCATION OF WELL: Owner's No. 1
CITY AND STATE: Hubbard, Oregon

NE 1/4 NE 1/4 Sec. 35 T. 4 N. S. R. 1 E. W., W.M.

Bearing and distance from section or subdivision corner
1504' E. & 1442' N. from SW cor.
Wm. Vanderwacker DLC

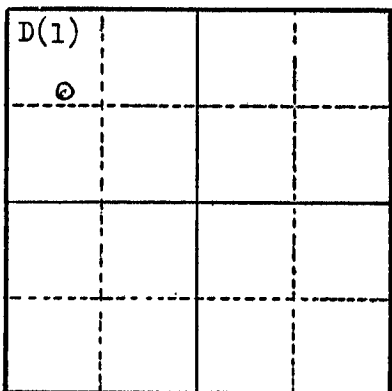

Section 35

Altitude at well 160' Interpolated

TYPE OF WELL: Drilled Date Constructed Oct. 46

Depth drilled 210' Depth cased 210'

CASING RECORD:

12 inch steel casing 0 to 210 feet

FINISH:

Perforated 100 to 110' 200 to 210'

AQUIFERS:

WATER LEVEL:

60 feet

PUMPING EQUIPMENT: Type Elec. turbine H.P. 15
Capacity 300 G.P.M.

WELL TESTS:

Drawdown 40 ft. after hours 250 G.P.M.
Drawdown ft. after hours G.P.M.

USE OF WATER Irrigation Temp. °F. 19

SOURCE OF INFORMATION GR-751

DRILLER or DIGGER Strasser, Portland

ADDITIONAL DATA:

Log None Water Level Measurements Chemical Analysis Aquifer Test

REMARKS: