

STATE ENGINEER
Salem, Oregon

MAR 1068

Well Record

STATE WELL NO. 4/2W - 4E
COUNTY MARION
APPLICATION NO. GR-2216

OWNER: W. W. Dreher


MAILING ADDRESS: Star Route

LOCATION OF WELL: Owner's No. _____

CITY AND STATE: Newberg, Oregon

SW 1/4 NW 1/4 Sec. 4 T. 4 N. S. R. 2 E. W., W.M.

Bearing and distance from section or subdivision corner 1240' E. and 2460' S.

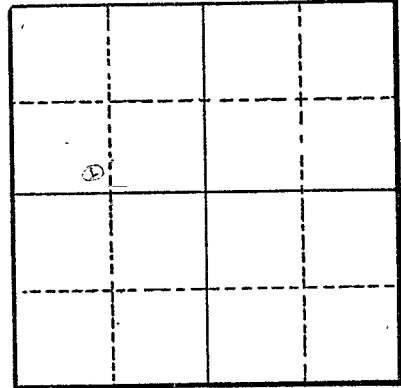

Altitude at well 190

Section 4

TYPE OF WELL: Drilled Date Constructed 1950

Depth drilled 310 Depth cased 310 75

CASING RECORD:

10-Inch 0 - 310 ft.
6-Inch 0 - 75 ft.

FINISH:

AQUIFERS:

Clay and sand

WATER LEVEL:

18-Feet

PUMPING EQUIPMENT: Type Peerless Turbine H.P. 40
Capacity 500 G.P.M.

WELL TESTS:

Drawdown 125 ft. after _____ hours Pumping 550 G.P.M.
Drawdown _____ ft. after _____ hours _____ G.P.M.

USE OF WATER Irrigation - 90 acres Temp. _____ °F. _____, 19____

SOURCE OF INFORMATION GR-2121

DRILLER or DIGGER J. T. Miller

ADDITIONAL DATA:
Log Water Level Measurements _____ Chemical Analysis _____ Aquifer Test _____

REMARKS:

86 acres (85.6) ?

