

STATE ENGINEER
Salem, Oregon

MARI. 1070 Well Record

STATE WELL NO. 4/21141
COUNTY Marion
APPLICATION NO. GR-3669

OWNER: Albert Susarr

MAILING ADDRESS: Star Route Box 47

LOCATION OF WELL: Owner's No.


CITY AND STATE: Newberg, Oregon

pg 1 of 4

NE 1/4 SW 1/4 Sec. 4 T. 4 S. R. 2 W., W.M.

Bearing and distance from section or subdivision

corner 2600' N. & 2150' E. from SW cor. Sec. 4

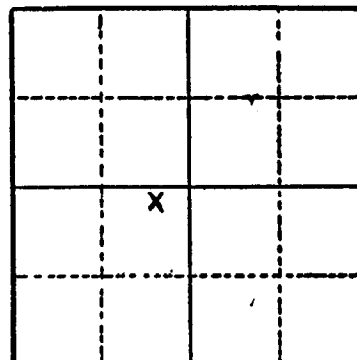

Section 4

Altitude at well

TYPE OF WELL: Drilled Date Constructed May, 1952

Depth drilled 130 feet Depth cased 130 feet

CASING RECORD:

8 inch casing set to 130 feet

FINISH:

AQUIFERS:

WATER LEVEL:

PUMPING EQUIPMENT: Type General Electric H.P. 5
Capacity G.P.M.

WELL TESTS:
Drawdown ft. after hours 225 G.P.M.
Drawdown ft. after hours G.P.M.

USE OF WATER Irrigation Temp. °F., 19

SOURCE OF INFORMATION Well Registration Statement

DRILLER or DIGGER

ADDITIONAL DATA:

Log X Water Level Measurements Chemical Analysis Aquifer Test

REMARKS:

3365

STATE ENGINEER
Salem, Oregon

MARI. 1070

Well Record

STATE WELL NO. 4/2W-4L(1)
COUNTY Marion
APPLICATION NO. GR 3169

OWNER: Albert Swan


MAILING ADDRESS: Pg 3 of 4

LOCATION OF WELL: Owner's No.

CITY AND STATE:

1/4 1/4 Sec. T. N. S., R. E. W., W.M.

Bearing and distance from section or subdivision corner

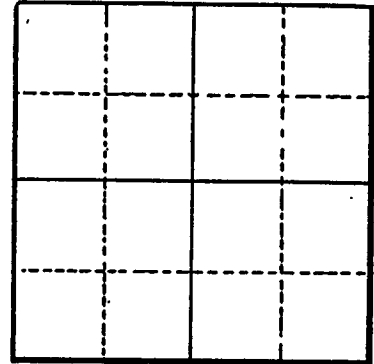

Section

Altitude at well 172

TYPE OF WELL: Drilled Date Constructed 1952

Depth drilled 130 Depth cased

CASING RECORD:

8 inch

FINISH:

AQUIFERS:

Pumice and sand from 125 to 130

WATER LEVEL:

PUMPING EQUIPMENT: Type Capacity G.P.M. H.P.

WELL TESTS:

Drawdown ft. after hours G.P.M.

Drawdown ft. after hours G.P.M.

USE OF WATER Irrigation--34 acres Temp. °F., 19

SOURCE OF INFORMATION USGS

DRILLER or DIGGER

ADDITIONAL DATA:

Log Water Level Measurements Chemical Analysis Aquifer Test

REMARKS:

