

STATE ENGINEER
Salem, Oregon

MARI. 1071

Well Record

STATE WELL NO. 4/2W-4L(1)
COUNTY Marion
APPLICATION NO. 683119

OWNER: Albert Swan


MAILING ADDRESS:

LOCATION OF WELL: Owner's No.

CITY AND STATE:

1/4 1/4 Sec. T. N. S., R. E. W., W.M.

Bearing and distance from section or subdivision corner

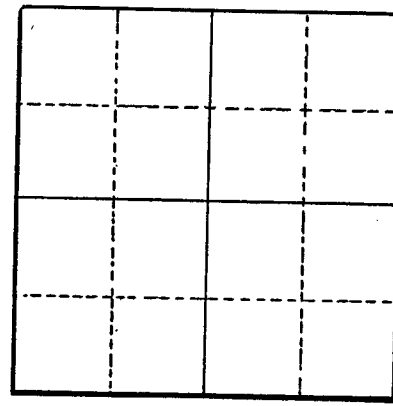

Section

Altitude at well 172

TYPE OF WELL: Drilled Date Constructed 1952

Depth drilled 130 Depth cased

CASING RECORD:

8 inch

FINISH:

AQUIFERS:

Pumice and sand from 125 to 130

WATER LEVEL:

PUMPING EQUIPMENT: Type Capacity G.P.M. H.P.

WELL TESTS:

Drawdown ft. after hours G.P.M.
Drawdown ft. after hours G.P.M.

USE OF WATER Irrigation--34 acres Temp. °F., 19

SOURCE OF INFORMATION USGS

DRILLER or DIGGER

ADDITIONAL DATA:

Log Water Level Measurements Chemical Analysis Aquifer Test

REMARKS:

