

MARI 10907

STATE ENGINEER **MARI**
Salem, Oregon **10907**

Well Record

STATE WELL NO. 8/2W-25Q
COUNTY Marion
APPLICATION NO. GR-3543

OWNER: City of Aumsville

MAILING
ADDRESS: _____

LOCATION OF WELL: Owner's No. _____

CITY AND
STATE: _____

Aumsville, Oregon

SW $\frac{1}{4}$ SE $\frac{1}{4}$ Sec. 25 T. 8 N. S., R. 2 E. W., W.M.


Bearing and distance from section or subdivision

corner S. 71° 10' E., 157.6 ft. from the NE corner
of Block 1 of Turner Addition to Aumsville

Altitude at well _____

TYPE OF WELL: Drilled Date Constructed Aug., 1948

Depth drilled 75 ft. Depth cased 75 ft.

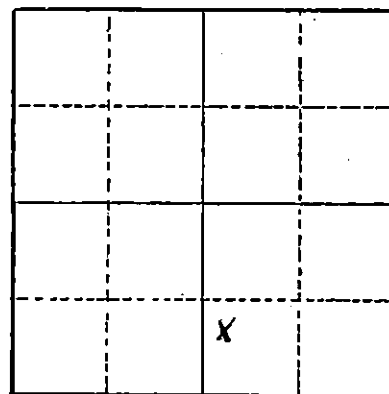

Section 25

CASING RECORD:

6 inch casing set to 75 ft.

FINISH:

AQUIFERS:

WATER LEVEL:

PUMPING EQUIPMENT: Type Peerless Centrifugal H.P. 5
Capacity 85 G.P.M.

WELL TESTS:

Drawdown 50 ft. after _____ hours 75 G.P.M.

Drawdown _____ ft. after _____ hours _____ G.P.M.

USE OF WATER Municipal Temp. _____ °F., 19 _____

SOURCE OF INFORMATION Well Registration Statement

DRILLER or DIGGER Fred Wymore

ADDITIONAL DATA:

Log _____ Water Level Measurements _____ Chemical Analysis _____ Aquifer Test _____

REMARKS: