

STATE ENGINEER
Salem, Oregon

MARI. 10943 Well Record

STATE WELL NO. 8/2W-25cd
COUNTY Marion
APPLICATION NO. G-100

OWNER: Calvin D. Garver


MAILING ADDRESS: Box 102

LOCATION OF WELL: Owner's No.

CITY AND STATE: Aumsville, Oregon

SE 1/4 SW 1/4 Sec. 25 T. 8 N. S., R. 2 E. W., W.M.

Bearing and distance from section or subdivision corner 300 feet South and 1170 feet East of the NW Corner of J. McHaley DLC

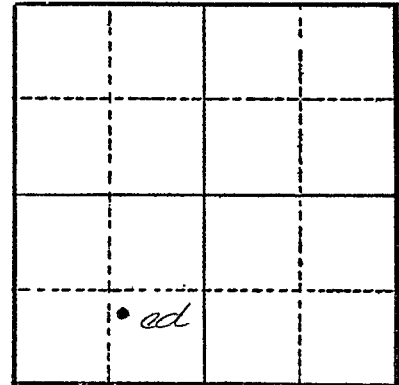

Section 25

Altitude at well

TYPE OF WELL: Drilled Date Constructed Sept., 1955

Depth drilled 82 feet Depth cased 53 feet

CASING RECORD:

8-inch set from 0 to 53 feet

FINISH:

perforations from 21 to 41 feet

AQUIFERS:

gravel from 82 to 82 feet

WATER LEVEL:

5 feet below land surface October 4, 1955

PUMPING EQUIPMENT: Type H.P.

Capacity G.P.M.

WELL TESTS:

Drawdown 68 ft. after hours pumping 68 G.P.M.

Drawdown ft. after hours G.P.M.

USE OF WATER Irrigation Temp. 55 °F. September, 1955

SOURCE OF INFORMATION Well Driller's Report

DRILLER or DIGGER J. A. Sneed & Sons

ADDITIONAL DATA:

Log Water Level Measurements Chemical Analysis Aquifer Test

REMARKS:

