

STATE ENGINEER  
Salem, Oregon

MARI.....

# Well Record

STATE WELL NO. 8/2W-25bb  
COUNTY Marion  
APPLICATION NO. GR-441

OWNER: Victor Schaefer


MAILING ADDRESS: Route 5, Box 15

LOCATION OF WELL: Owner's No.

CITY AND STATE: Salem, Oregon

NW 1/4 NW 1/4 Sec. 25 T. 8 N. S., R. 2 W., W.M.

Bearing and distance from section or subdivision corner 1150 feet South and 300 feet East from the NW Corner, Section 25

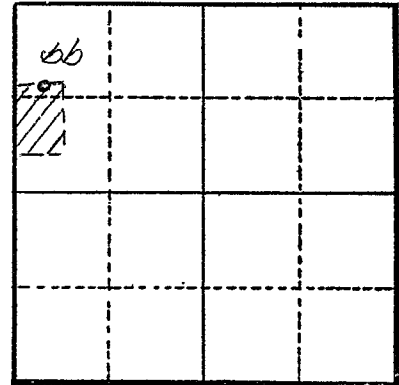

Section 25

Altitude at well

TYPE OF WELL: Drilled Date Constructed Nov. 52

Depth drilled 98 feet Depth cased 98 feet

CASING RECORD:  
8-inch

FINISH:

AQUIFERS:

WATER LEVEL:

9

PUMPING EQUIPMENT: Type Turbine, Jacuzzi H.P. 7 1/2  
Capacity 125 G.P.M.

WELL TESTS:

Drawdown 20 ft. after 125 hours G.P.M.

Drawdown ft. after hours G.P.M.

USE OF WATER Irrigation 20 acres Temp. °F., 19

SOURCE OF INFORMATION GR-427

DRILLER or DIGGER

ADDITIONAL DATA:

Log Water Level Measurements Chemical Analysis Aquifer Test

REMARKS:

|                                                 |    |         |
|-------------------------------------------------|----|---------|
| loose soil and gravel                           | 0  | 15 feet |
| cemented gravel and cobblestone - water bearing | 15 | 54 feet |
| blue clay, sand, gravel, water-bearing          | 54 | 84 feet |
| sand and mud - gravel and rock (some cemented)  | 84 | 98 feet |