

STATE ENGINEER
Salem, Oregon

MARION 18945 Well Record
maxi


STATE WELL NO. 8/2W-25L
COUNTY Marion
APPLICATION NO. GR-3569

OWNER: Hoyt Cupp MAILING ADDRESS: Route 5, Box 153

LOCATION OF WELL: Owner's No. CITY AND STATE: Salem, Oregon

NE 1/4 SW 1/4 Sec. 25 T. 8 S., R. 2 W., W.M.

Bearing and distance from section or subdivision corner 500 ft. from the NW corner of Cupp land by deed recorded in Vol. 355, P. 132, Marion County Records

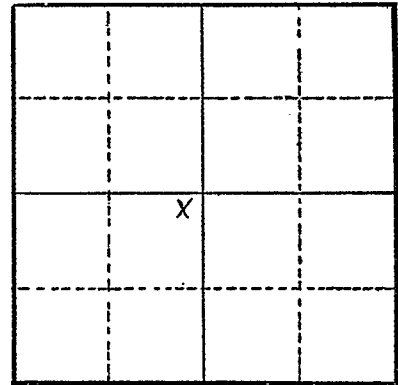

Section 25

Altitude at well

TYPE OF WELL: Dug Date Constructed 1945

Depth drilled 21 ft. Depth cased

CASING RECORD:

FINISH:

AQUIFERS:

500 ft from NW corner Cupp Land, Deed recorded V355 P132 Marion County

WATER LEVEL:

PUMPING EQUIPMENT: Type Bingham Centrifugal Capacity 150 G.P.M. H.P.

WELL TESTS: Drawdown ft. after hours G.P.M. Drawdown ft. after hours G.P.M.

USE OF WATER Irrigation Temp. °F., 19

SOURCE OF INFORMATION Well Registration Statement

DRILLER or DIGGER

ADDITIONAL DATA:

Log X Water Level Measurements Chemical Analysis Aquifer Test

REMARKS:

Log: Soil Thickness 3
Clay, blue 4
Gravel 14