

STATE ENGINEER
Salem, Oregon

Well Record


STATE WELL NO. 4/2W-6B
COUNTY Marion
APPLICATION NO. GR-3933

MAR. 10 1966

OWNER: Burnell Olson
MAILING ADDRESS: Star Route pg 1 of 2
CITY AND STATE: Newberg, Oregon

LOCATION OF WELL: Owner's No. _____
Well # 2
NW 1/4 NE 1/4 Sec. 6 T. 4 S. R. 2 W., W.M.

Bearing and distance from section or subdivision
corner 1000' S. & 200' E. from N¹/₄ Cor. Sec. 6

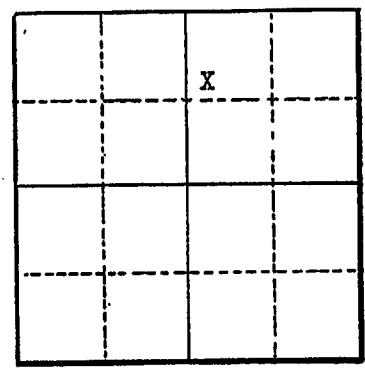

Section 6

Altitude at well _____

TYPE OF WELL: Drilled Date Constructed 3/52

Depth drilled 36 ft. Depth cased 36 ft.

CASING RECORD:

12 inch casing set to 36 ft.

FINISH:

perforations from 26 to 36 ft.

AQUIFERS:

WATER LEVEL:

3 ft. below surface

PUMPING EQUIPMENT: Type Fairbanks Morse H.P. 10
Capacity 250 G.P.M.

WELL TESTS:
Drawdown 22 ft. after _____ hours 200 G.P.M.
Drawdown _____ ft. after _____ hours _____ G.P.M.

USE OF WATER Irrigation Temp. _____ °F., 19____
SOURCE OF INFORMATION Well Registration Statement Cert. # GR-3567

DRILLER or DIGGER _____
ADDITIONAL DATA:
Log Water Level Measurements _____ Chemical Analysis _____ Aquifer Test _____

REMARKS:

| | | | |
|------|------------|-----------|-----------------|
| Log: | | Thickness | Depth to Bottom |
| | Clay | 26 | |
| | Pea gravel | 10 | 36 |

STATE ENGINEER
Salem, Oregon

MAR. 1096

Well Record


STATE WELL NO. 4/2W-6B(1)
COUNTY Marion
APPLICATION NO. _____

OWNER: Burnel Olson

MAILING ADDRESS:
CITY AND STATE:

LOCATION OF WELL: Owner's No. _____
N. E.
S. R. W., W.M.
Bearing and distance from section or subdivision corner

Pg 2 of 2

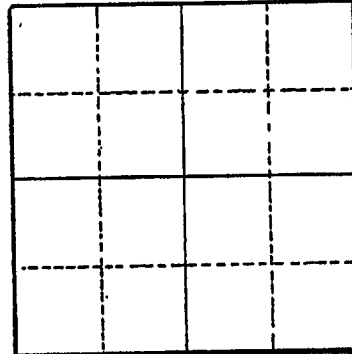

Section _____

Altitude at well 95
TYPE OF WELL: Drilled Date Constructed 1952
Depth drilled 36 Depth cased 36

CASING RECORD:
12 inch

FINISH:
Casing perforated 26-36

AQUIFERS:
Fine gravel from 26 to 36

WATER LEVEL:
3 feet below land surface, July, 1952

PUMPING EQUIPMENT: Type Centrifugal H.P. 10
Capacity _____ G.P.M.

WELL TESTS:
Drawdown _____ ft. after _____ hours _____ G.P.M.
Drawdown _____ ft. after _____ hours _____ G.P.M.

USE OF WATER Irrigation-35 acres Temp. _____ °F. _____, 19_____

SOURCE OF INFORMATION USGS

DRILLER or DIGGER _____

ADDITIONAL DATA:
Log _____ Water Level Measurements _____ Chemical Analysis _____ Aquifer Test _____

REMARKS: