

STATE ENGINEER  
Salem, Oregon

MAR. ....  
~~11084~~ 11084  
**Well Record**

STATE WELL NO. 9/W-35B(1)  
COUNTY Marion  
APPLICATION NO. GR-485

OWNER: David & Wilma Turnidge

MAILING  
ADDRESS:


LOCATION OF WELL: Owner's No. 11

CITY AND  
STATE:

Jefferson, Oregon

NW 1/4 NE 1/4 Sec. 35 T. 9 S., R. 4 W., W.M.

Bearing and distance from section or subdivision  
corner 1320' W. & 470' S. of NE cor. of sec. 35

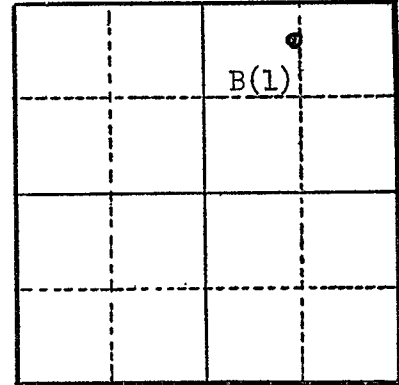

Altitude at well 175'

TYPE OF WELL: Drilled Date Constructed 1938

Depth drilled 30' Depth cased 20'

Section 35

CASING RECORD:

Dug pit - 5' x 5' x 10' deep

10 inch casing from 10 to 30 feet

FINISH:

AQUIFERS:

WATER LEVEL:  
14 feet

PUMPING EQUIPMENT: Type F. M. H.P. 10  
Capacity 250 G.P.M.

WELL TESTS:  
Drawdown ..... ft. after ..... hours ..... G.P.M.  
Drawdown ..... ft. after ..... hours ..... G.P.M.

USE OF WATER Irrigation (25 acres) Temp. °F. ...., 19.....

SOURCE OF INFORMATION GR-467

DRILLER or DIGGER

ADDITIONAL DATA:  
Log NA Water Level Measurements ..... Chemical Analysis ..... Aquifer Test .....

REMARKS: