

STATE ENGINEER
Salem, Oregon

Well Record

STATE WELL NO. 8/2W-290(1)
COUNTY Marion
APPLICATION NO. GR-1093

GR- 1054

MA. 1174
Marion

OWNER: Ben Wipper


MAILING ADDRESS: Rt. 1, Box 265

LOCATION OF WELL: Owner's No. #3

CITY AND STATE: Turner, Oregon

SW 1/4 SE 1/4 Sec. 29 T. 8 S., R. 2 W., W.M.

Bearing and distance from section or subdivision corner 500' N. & 400' E. from S 1/4 cor. Sec. 29.

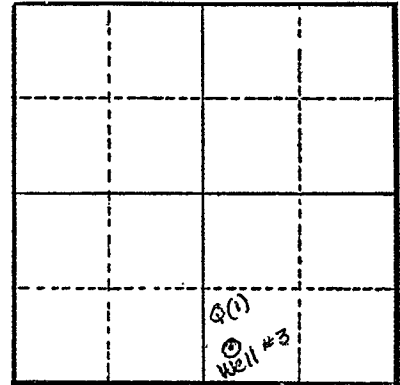

Section 29

Altitude at well

TYPE OF WELL: Dug Date Constructed 1950

Depth drilled 12 ft. Depth cased

CASING RECORD:

FINISH:

AQUIFERS:

WATER LEVEL:

2 ft.

PUMPING EQUIPMENT: Type Cornell Cent. H.P. 7 1/2

Capacity 350 G.P.M.

WELL TESTS:

Drawdown 10 ft. after 180 hours G.P.M.

Drawdown ft. after hours G.P.M.

USE OF WATER Irrigation Temp. °F., 19

SOURCE OF INFORMATION G. R. Record

DRILLER or DIGGER

ADDITIONAL DATA:

Log N.A. Water Level Measurements Chemical Analysis Aquifer Test

REMARKS:

Irrigation of 50 acres.