

STATE ENGINEER
Salem, Oregon

MARI...
11/24/46
MARI
Well Record

STATE WELL NO. 8/2W-32B(1)
COUNTY Marion
APPLICATION NO. GR-1091

OWNER: Ben Wipper

GR- 1052

MAILING ADDRESS: Rt. 1, Box 265


LOCATION OF WELL: Owner's No. #1

CITY AND STATE: Turner, Oregon

N. 1/4 NE 1/4 Sec. 32 T. 8 S., R. 2 W., W.M.

Bearing and distance from section or subdivision

corner 800' S. & 250' E. from N. cor. Sec. 32.

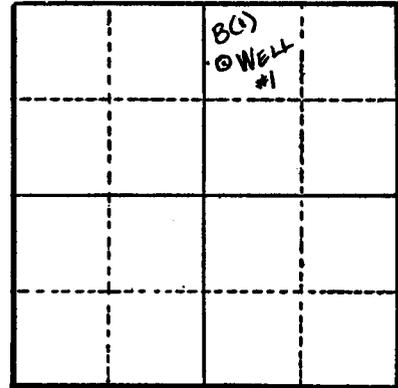

Section 32

Altitude at well 295 ft.

TYPE OF WELL: Dug Date Constructed 1946

Depth drilled 13 ft. Depth cased

CASING RECORD:

FINISH:

AQUIFERS:

WATER LEVEL:

2 ft.

PUMPING EQUIPMENT: Type Cornell Cent. 2 1/2" x 2" H.P. 7 1/2

Capacity 250 G.P.M.

WELL TESTS:

Drawdown 11 ft. after 150 hours G.P.M.

Drawdown ft. after hours G.P.M.

USE OF WATER Irrigation Temp. °F. 19

SOURCE OF INFORMATION G. R. Record

DRILLER or DIGGER

ADDITIONAL DATA:

Log N.A. Water Level Measurements Chemical Analysis Aquifer Test

REMARKS:

Irrigation of 40 acres.