

STATE ENGINEER
Salem, Oregon

MAR 11 2 43
marion

Well Record

STATE WELL NO. 8/2W-32E(1)
COUNTY Marion
APPLICATION NO. GR-1078

GR-1040

OWNER: Virgil R. & Anna Fickethier

MAILING ADDRESS:


LOCATION OF WELL: Owner's No.

CITY AND STATE:

Turner, Oregon

SW 1/4 NW 1/4 Sec. 32 T. 8 S., R. 2 W., W.M.

Bearing and distance from section or subdivision corner 1250' E. & 2050' S. from NW cor. Sec. 32.

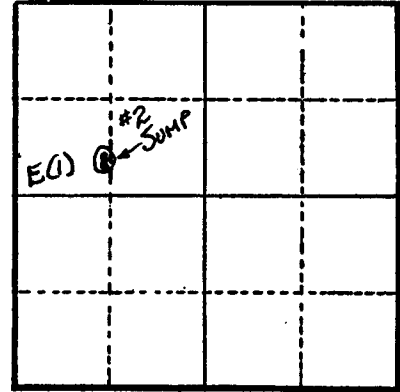

Section 32

Altitude at well 290 ft.

TYPE OF WELL: Sump Date Constructed 1952

Depth drilled 20 ft. Depth cased Sump

CASING RECORD:

Sump is 100' x 15' x 20'

FINISH:

AQUIFERS:

WATER LEVEL:

2 ft.

PUMPING EQUIPMENT: Type Cent. H.P. 8
Capacity 100 G.P.M.

WELL TESTS:

Drawdown ft. after hours G.P.M.
Drawdown ft. after hours G.P.M.

USE OF WATER Irrigation Temp. °F. 19

SOURCE OF INFORMATION GR Record

DRILLER or DIGGER

ADDITIONAL DATA:

Log N.A. Water Level Measurements Chemical Analysis Aquifer Test

REMARKS:

Irrigation of 24 acres.