

STATE ENGINEER
Salem, Oregon

MA 21.....

11244 Well Record
Marion GR- 1039

STATE WELL NO. 8/2W-32-F
COUNTY Marion
APPLICATION NO. GR- 1077

OWNER: Virgil R. & Anna Hicketier

MAILING ADDRESS:


LOCATION OF WELL: Owner's No. Sump #1

CITY AND STATE:

Turner, Oregon

SE 1/4 NW 1/4 Sec. 32 T. 8 N. S, R. 2 E. W., W.M.

Bearing and distance from section or subdivision corner 2200' E. & 1500' S. of NW cor. Sec. 32.

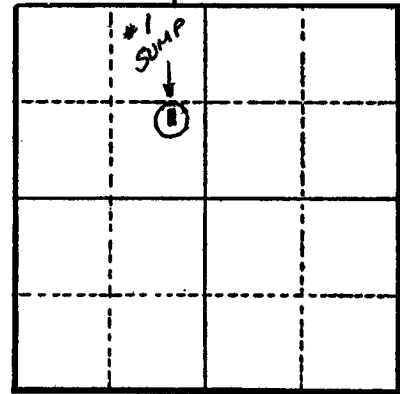

Section 32

Altitude at well 290 ft.

TYPE OF WELL: Sump Date Constructed 1952

Depth drilled 20 ft. Depth cased Sump

CASING RECORD:

FINISH:

AQUIFERS:

WATER LEVEL:

4 ft.

PUMPING EQUIPMENT: Type F. B. Cent. H.P. 7 1/2
Capacity 130 G.P.M.

WELL TESTS:

Drawdown ft. after hours G.P.M.
Drawdown ft. after hours G.P.M.

USE OF WATER Irrigation Temp. °F. 19

SOURCE OF INFORMATION G.R. Record

DRILLER or DIGGER

ADDITIONAL DATA:

Log N.A. Water Level Measurements Chemical Analysis Aquifer Test

REMARKS:

Irrigation of 30 acres.