

STATE ENGINEER  
Salem, Oregon

MARI. ....  
11245 Well Record  
MARI GR- 1053

STATE WELL NO. 8/2W-32G(1)  
COUNTY Marion  
APPLICATION NO. GR-1092

OWNER: Ben Wipper


MAILING ADDRESS: Rt. 1, Box 265

LOCATION OF WELL: Owner's No. #2

CITY AND STATE: Turner, Oregon

SW 1/4 NE 1/4 Sec. 32 T. 8 S., R. 2 W., W.M.

Bearing and distance from section or subdivision  
corner 520' E. & 630' N. from Center of Sec. 32.

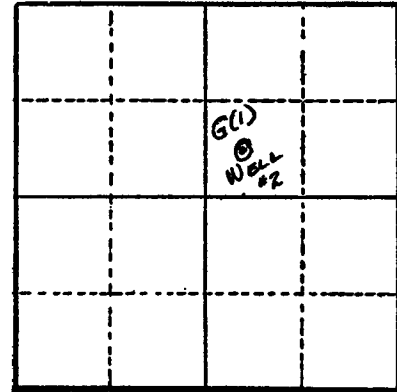

Section 32

Altitude at well

TYPE OF WELL: Dug Date Constructed 1948

Depth drilled 12 ft. Depth cased

CASING RECORD:

FINISH:

AQUIFERS:

WATER LEVEL:

2 ft.

PUMPING EQUIPMENT: Type Wiseman Cent. 1 1/2" x 2 1/2" H.P. 10  
Capacity 150 G.P.M.

WELL TESTS:

Drawdown 8 ft. after 100 hours G.P.M.

Drawdown ft. after hours G.P.M.

USE OF WATER Irrigation Temp. °F. 19

SOURCE OF INFORMATION G. R. Record

DRILLER or DIGGER

ADDITIONAL DATA:

Log N.A. Water Level Measurements Chemical Analysis Aquifer Test

REMARKS:

Irrigation of 40 acres.