

STATE ENGINEER
Salem, Oregon

M.A. 31.....
11276
ma

Well Record

STATE WELL NO. 8/2W-34cc
COUNTY Marion
APPLICATION NO. GR-2076

OWNER: John S. Peterson


MAILING ADDRESS: Route 1, Box 18

LOCATION OF WELL: Owner's No.

CITY AND STATE: Turner, Oregon

SW 1/4 SW 1/4 Sec. 34 T. 8 S., R. 2 W., W.M.

Bearing and distance from section or subdivision corner 946 feet North and 224 feet East

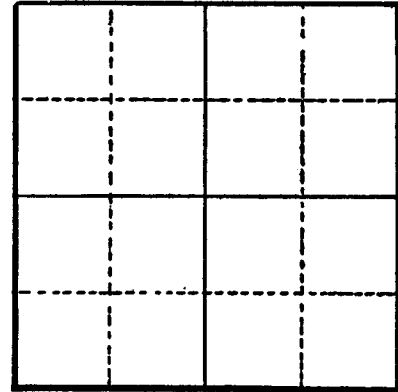

Altitude at well

TYPE OF WELL: Drilled Date Constructed 1953

Depth drilled 33 feet Depth cased 33 feet

CASING RECORD:

8-inch

FINISH:

perforations from 21 to 33 feet

AQUIFERS:

WATER LEVEL:

6 feet

PUMPING EQUIPMENT: Type Allis Chalmers Centrifugal H.P. 5
Capacity 150 G.P.M.

WELL TESTS:

Drawdown 10 ft. after pumping 112.5 hours G.P.M.
Drawdown ft. after hours G.P.M.

USE OF WATER Irrigation Temp. °F. 19

SOURCE OF INFORMATION GR-1995

DRILLER or DIGGER West Well Drilling, 4120 Market Street, Salem, Oregon

ADDITIONAL DATA:

Log Water Level Measurements Chemical Analysis Aquifer Test

REMARKS: