

STATE ENGINEER
Salem, Oregon

Well Record

STATE WELL NO. 8/2W-34J
COUNTY Marion
APPLICATION NO. GR-3939

11281
Marion

OWNER: C. L. Mann


MAILING ADDRESS: Route 1, Box 217E

LOCATION OF WELL: Owner's No. _____

CITY AND STATE: Aumsville, Oregon

NE 1/4 SE 1/4 Sec. 34 T. 8 S., R. 2 W., W.M.

Bearing and distance from section or subdivision
corner 300' W. & 1500' N. from SE Cor. Sec. 34

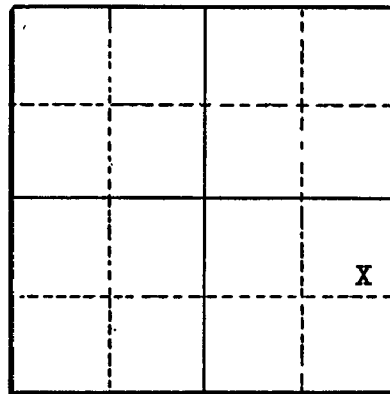

Section 34

Altitude at well _____

TYPE OF WELL: Dug Date Constructed 1953

Depth drilled 20 ft. Depth cased _____

CASING RECORD:

FINISH:

AQUIFERS:

WATER LEVEL:

3 feet below surface

PUMPING EQUIPMENT: Type centrifugal (to be changed) H.P. 5
Capacity 135 G.P.M.

WELL TESTS:

Drawdown _____ ft. after _____ hours _____ G.P.M.
Drawdown _____ ft. after _____ hours _____ G.P.M.

USE OF WATER Irrigation Temp. _____ °F. _____, 19____

SOURCE OF INFORMATION Well Registration Statement Cert. # GR-3572

DRILLER or DIGGER _____

ADDITIONAL DATA:

Log _____ Water Level Measurements _____ Chemical Analysis _____ Aquifer Test _____

REMARKS: