

STATE ENGINEER  
Salem, Oregon

# Well Record

STATE WELL NO. 8/2W-35L  
COUNTY MARION  
~~APPLICATION NO.~~ GR-2436

*11293  
marion*

OWNER: Ralph Lester Beach and Edith G. Beach


MAILING ADDRESS: Rt. 1, Box 217-D

LOCATION OF WELL: Owner's No. \_\_\_\_\_

CITY AND STATE: Aumsville, Oregon

NE 1/4 SW 1/4 Sec. 35 T. 8 S., R. 2 W., W.M.

Bearing and distance from section or subdivision corner 280' N. and 235' W.

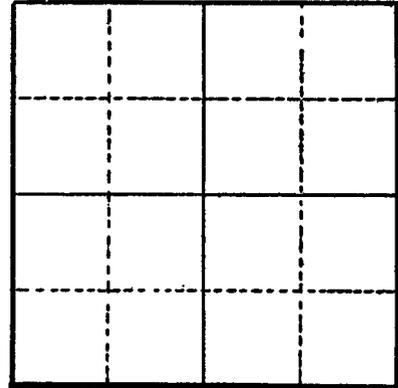

Section \_\_\_\_\_

Altitude at well \_\_\_\_\_

TYPE OF WELL: \_\_\_\_\_ Date Constructed \_\_\_\_\_

Depth drilled \_\_\_\_\_ Depth cased \_\_\_\_\_

### CASING RECORD:

### FINISH:

### AQUIFERS:

### WATER LEVEL:

PUMPING EQUIPMENT: Type Pacific H.P. 7 1/2  
Capacity 375 G.P.M.

### WELL TESTS:

Drawdown \_\_\_\_\_ ft. after \_\_\_\_\_ hours \_\_\_\_\_ G.P.M.

Drawdown \_\_\_\_\_ ft. after \_\_\_\_\_ hours \_\_\_\_\_ G.P.M.

USE OF WATER Irrigation Temp. \_\_\_\_\_ °F. \_\_\_\_\_, 19 \_\_\_\_\_

SOURCE OF INFORMATION GR-2311

DRILLER or DIGGER \_\_\_\_\_

### ADDITIONAL DATA:

Log \_\_\_\_\_ Water Level Measurements \_\_\_\_\_ Chemical Analysis \_\_\_\_\_ Aquifer Test \_\_\_\_\_

### REMARKS: