

STATE ENGINEER
Salem, Oregon

M 1 21 1345
Well Record

STATE WELL NO. 8/3W-2B
COUNTY Marion
APPLICATION NO. GR-4206

OWNER: Lloyd E. & Doris H. Cox


MAILING ADDRESS: 2050 Vista Ave., S.E.

LOCATION OF WELL: Owner's No. _____

CITY AND STATE: Salem, Oregon

NW 1/4 NE 1/4 Sec. 2 T. 8 S., R. 3 W., W.M.

Bearing and distance from section or subdivision
corner S. 549' & E. 161' of 1/4 S. Cor. on N. line Sec. 2

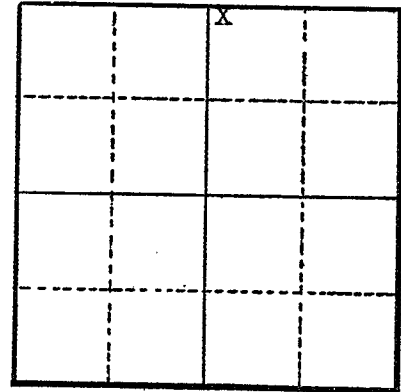

Section 2

Altitude at well _____

TYPE OF WELL: Drilled Date Constructed 1939

Depth drilled 41' Depth cased 41'

CASING RECORD:

4 in. steel casing set to 41 feet

FINISH:

AQUIFERS:

WATER LEVEL:

10 feet below surface

PUMPING EQUIPMENT: Type Jacuzzi shallow well jet H.P. 1
Capacity 25 G.P.M.

WELL TESTS:

Drawdown _____ ft. after _____ hours _____ G.P.M.
Drawdown _____ ft. after _____ hours _____ G.P.M.

USE OF WATER Irrigation Temp. _____ °F. _____, 19____

SOURCE OF INFORMATION Well Registration Statement Cert. # GR-3756

DRILLER or DIGGER _____

ADDITIONAL DATA:

Log _____ Water Level Measurements _____ Chemical Analysis _____ Aquifer Test _____

REMARKS: