

STATE ENGINEER
Salem, Oregon

Well Record

STATE WELL NO. 8/31-22(1)
COUNTY Marion
APPLICATION NO. GR- 2087

M 13
11350

OWNER: Oregon Fairview Homes

MAILING ADDRESS: 2250 Strong Rd.

LOCATION OF WELL: Owner's No. 1

CITY AND STATE: Salem, Oregon


NE ¼ SE ¼ Sec. 2 T. 8 S., R. 3 W., W.M.

Bearing and distance from section or subdivision corner 2200' W. & 600' N. of the SE corner of section 2.

Altitude at well 235

TYPE OF WELL: Drilled Date Constructed 1922

Depth drilled 265 Depth cased 62

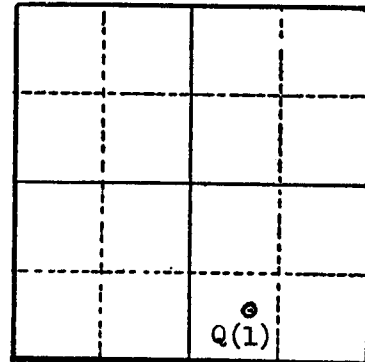

Section 2

CASING RECORD:

12 inch to 62 feet

FINISH:

AQUIFERS:

Weathered basalt

WATER LEVEL:

45 feet

PUMPING EQUIPMENT: Type Bingham, turbine

H.P. 25

Capacity 250 G.P.M.

WELL TESTS:

Drawdown 70 ft. after hours 280 G.P.M.

Drawdown 130 ft. after hours 320 G.P.M.

USE OF WATER Irrigation & domestic

Temp. °F., 19

SOURCE OF INFORMATION GR- 2005

DRILLER or DIGGER

ADDITIONAL DATA:

Log X Water Level Measurements Chemical Analysis Aquifer Test

REMARKS:

Cased from 0 to 62 with 12" pipe
Rock indicated 62 to 242
Soft blue shale 242 to 265
Shale closes back to 242'