

STATE ENGINEER  
Salem, Oregon

# Well Record

STATE WELL NO. 4/2W-9N  
COUNTY Marion  
APPLICATION NO. GR-1810

1137  
MARI....

GR- 1751

OWNER: Donald J. Buysert


MAILING ADDRESS: P.O. Box 5

LOCATION OF WELL: Owner's No. \_\_\_\_\_

CITY AND STATE: St. Paul, Oregon

SW  $\frac{1}{4}$  SW  $\frac{1}{4}$  Sec. 9 T. 4 S., R. 2 W., W.M.

Bearing and distance from section or subdivision corner 400' N. & 900' E. from SW cor. Sec. 9

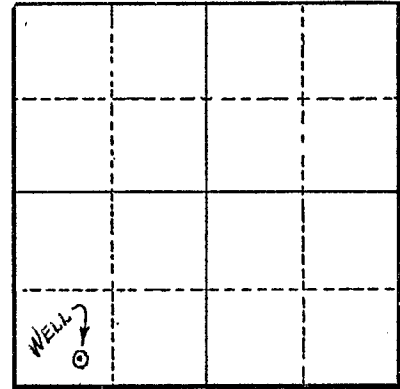

Section 9

Altitude at well 170

TYPE OF WELL: Drilled Date Constructed 1952

Depth drilled 77' Depth cased 70'

### CASING RECORD:

8"

### FINISH:

### AQUIFERS:

### WATER LEVEL:

12' - January '52

PUMPING EQUIPMENT: Type Peerless turbine H.P. 7 $\frac{1}{2}$   
Capacity 150 G.P.M.

### WELL TESTS:

Drawdown \_\_\_\_\_ ft. after \_\_\_\_\_ hours \_\_\_\_\_ G.P.M.  
Drawdown \_\_\_\_\_ ft. after \_\_\_\_\_ hours \_\_\_\_\_ G.P.M.

USE OF WATER Irrigation - 80 acres Temp. \_\_\_\_\_ °F. \_\_\_\_\_, 19\_\_\_\_

SOURCE OF INFORMATION GR Record

DRILLER or DIGGER J. T. Miller

### ADDITIONAL DATA:

Log N.A. Water Level Measurements \_\_\_\_\_ Chemical Analysis \_\_\_\_\_ Aquifer Test \_\_\_\_\_

### REMARKS:

Irrigation of 80 acres.