

STATE ENGINEER
Salem, Oregon

MAR 11 1941

Well Record

STATE WELL NO. ^W 4/23 - 100
COUNTY ~~YAMHILL~~ Marion
APPLICATION NO. GR-2194

OWNER: Frank T. Wilcox


MAILING ADDRESS: Newberg,

LOCATION OF WELL: Owner's No.

CITY AND STATE: Oregon

SW 1/4 SE 1/4 Sec. 10 T. 4 S., R. 2 W.M.

Bearing and distance from section or subdivision corner 1025' N. and 1370' W.

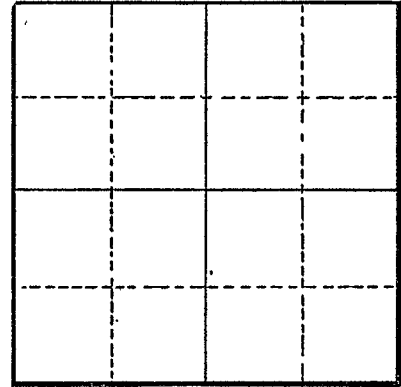

Section

Altitude at well

TYPE OF WELL: Drilled Date Constructed 1947

Depth drilled 110 Depth cased 110

CASING RECORD:

10-Inch

FINISH:

AQUIFERS:

WATER LEVEL:

35-Feet

PUMPING EQUIPMENT: Type Turbine H.P. 30
Capacity 700 G.P.M.

WELL TESTS:

Drawdown 770 ft. after hours Pumping 1000 G.P.M.

Drawdown ft. after hours G.P.M.

USE OF WATER Irrigation Temp. °F., 19

SOURCE OF INFORMATION GR-2099

DRILLER or DIGGER

ADDITIONAL DATA:

Log Water Level Measurements Chemical Analysis Aquifer Test

REMARKS: